


WELL PLUGGING RECORD

Give All Information Completely
Make Required Affidavit
Mail or Deliver Report to:
Conservation Division
State Corporation Commission
800 Biting Building
Wichita, Kansas

NORTH

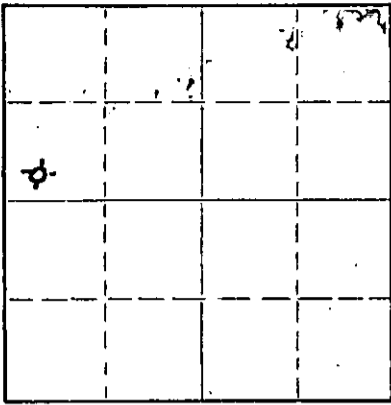

Locate well correctly on above
Section Plat

Barber County. Sec. 16 Twp. 32S Rge. (X) 12 (W)
Location as "NE/CNWxSWx" or footage from lines SW SW NW
Lease Owner Champlin Oil & Refining Co.
Lease Name Lee Simpson Well No. 1
Office Address Box 167, Ellinwood, Kansas
Character of Well (completed as Oil, Gas or Dry Hole) Dry hole
Date well completed April 9 1959
Application for plugging filed April 9 1959
Application for plugging approved April 9 (Verbal) 1959
Plugging commenced April 9 1959
Plugging completed April 9 1959
Reason for abandonment of well or producing formation

If a producing well is abandoned, date of last production 19
Was permission obtained from the Conservation Division or its agents before plugging was commenced? Yes

Name of Conservation Agent who supervised plugging of this well W. L. Lackamp, Jr.
Producing formation Depth to top Bottom Total Depth of Well 4751 Feet
Show depth and thickness of all water, oil and gas formations.

OIL, GAS OR WATER RECORDS

CASING RECORD

FORMATION	CONTENT	FROM	TO	SIZE	PUT IN	PULLED OUT
				8-5/8" OD	241'	None

Describe in detail the manner in which the well was plugged, indicating where the mud fluid was placed and the method or methods used in introducing it into the hole. If cement or other plugs were used, state the character of same and depth placed, from feet to feet for each plug set.

Filled hole with heavy rotary mud to 230'. Pushed plug to 230' and dumped in 1/3 sack of hulls and pumped in 20 sacks of cement then filled hole with heavy mud to 35' pushed plug to 35' and dumped in 1/2 sack of hulls and pumped in 10 sacks of cement filling hole to bottom of cellar.

RECEIVED
STATE CORPORATION COMMISSION

4-11-59

APR 11 1959

CONSERVATION DIVISION
Wichita, Kansas

(If additional description is necessary, use BACK of this sheet)

Name of Plugging Contractor Graham-Michaelis Drilling Co.
Address 212 N. Broadway, Wichita, Kansas

STATE OF Kansas COUNTY OF Barton ss.
J. W. Meyers (employee of owner) or (owner or operator) of the above-described well, being first duly sworn on oath, says: That I have knowledge of the facts, statements, and matters herein contained and the log of the above-described well as filed and that the same are true and correct. So help me God.

(Signature) [Signature]
Box 167, Ellinwood, Kansas
(Address)

SUBSCRIBED AND SWORN TO before me this 10th day of April, 1959

My commission expires 5-22-62

Notary Public.

PLUGGING
FILE SEC. 16 T. 32 R. 12W
BOOK PAGE 29 LINE 23

TO KANSAS CORPORATION COMMISSION
 Conservation Division
 800 Bitting Building
 Wichita, Kansas

County Barber SEC. 16 TWP. 32 RGE. 12W


COMPANY OPERATING Champlin Oil & Refining Co.

OFFICE ADDRESS Box 167, Ellinwood, Kansas

FARM NAME Lee Simpson WELL NO. 1

WELL LOCATED 330' from West line, 330' from South line
of NW $\frac{1}{4}$

CHARACTER OF WELL Dry hole

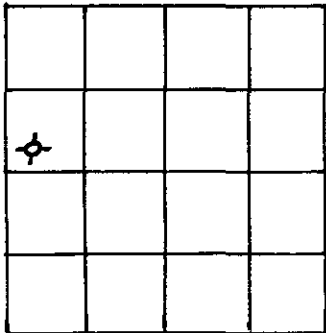

DRILLING COMMENCED 3-21-59 DRILLING COMPLETED 4-9-59

SIZE	WEIGHT	THDS	MAKE	FT.	AMOUNT PULLED	CEMENT
8-5/8	24#	8rd.	Smls.	241	None	200

FORMATION RECORD

TOPS	BOTTOM		TOPS	BOTTOM
0	242	Surface sand & shale		
242	1031	Shale		
1031	1428	Shale and shells		
1428	1903	Shale and lime		
1903	2280	Lime and shale		
2280	2966	Shale and lime		
2966	3465	Lime and shale		
3465	3736	Shale and lime		
3736	3880	Lime and shale		
3880	4342	Lime		
4342	4395	Lime and chert		
4395	4462	Lime		
4462	4473	Lime and chert		
4473	4518	Lime		
4518	4562	Shale and lime		
4565	4672	Lime		
4672	4683	Chert and lime		
4683	4709	Lime and shale		
4709	4730	Lime		
4730	4738	Sand and shale		
4738	4751	Shale and sand		
4751		Total Depth		

RECEIVED
 STATE CORPORATION COMMISSION
 APR 11 1959
 CONSERVATION DIVISION
 Wichita, Kansas

[Signature]
 Superintendent

[Signature]
 Notary Public

Subscribed and sworn to before me
 this 10 day of April, 1959

My commission expires 5-22-62

PLUGGING
 FILE SEC. 16 T 32 R 12W
 BOOK PAGE 29 LINE 23