

STATE OF KANSAS
STATE CORPORATION COMMISSION


WELL PLUGGING RECORD

Give All Information Completely
Make Required Affidavit
Mail or Deliver Report to
Conservation Division
State Corporation Comm.
245 North Water
Wichita, KS 67202

Barber County, Sec. 14 Twp. 32S Rge. 12 ~~XX~~/W
Location as "NE/CNW 1/4 SW 1/4" or footage from lines
NE SE NE

Lease Owner Aylward Drilling Company
Lease Name Krehbiel Well No. 1
Office Address 909 First National Bank Bldg., Wichita, Kansas
Character of Well (Completed as Oil, Gas or Dry Hole)
Dry Hole

Date Well completed July 15, 1981
Application for plugging filed July 15, 1981
Application for plugging approved July 15, 1981
Plugging commenced July 15, 1981
Plugging completed July 15, 1981
Reason for abandonment of well or producing formation

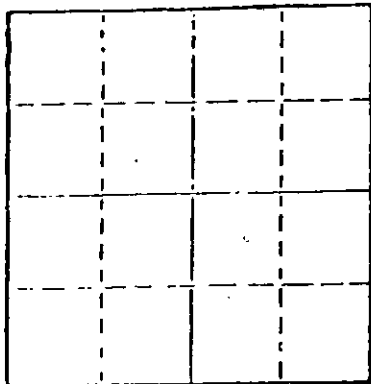

Locate well correctly on above
Section Plat

If a producing well is abandoned, date of last production 19

Was permission obtained from the Conservation Division or
its agents before plugging was commenced? Yes

Name of Conservation Agent who supervised plugging of this well Maurice Leslie, Nashville, Kansas
Producing formation Depth to top Bottom Total Depth of Well 4350'
Show depth and thickness of all water, oil and gas formations.

OIL, GAS OR WATER RECORDS

CASING RECORD

FORMATION	CONTENT	FROM	TO	SIZE	PUT IN	PULLED OUT
				8-5/8"	410'	None

Describe in detail the manner in which the well was plugged, indicating where the mud fluid was placed and the method or methods used in introducing it into the hold. If cement or other plugs were used, state the character of same and depth placed, from feet to feet for each plug set.

Pumped 50 sacks 50-50 posmix, 4% Gel, 3% CC. through drill pipe to 405 feet. Pushed bridge of hulls & plug to 40 feet with 10 sacks cement. Plugged rat hole with 10 sacks of cement and 2 sacks of cement in water well.

(If additional description is necessary, use BACK of this sheet)

Name of Plugging Contractor Graves Drilling Co., Inc.

STATE OF KANSAS COUNTY OF SEDGWICK, ss.
Betty Brandt (employee of owner) or (owner or operator)
of the above-described well, being first duly sworn on oath, says: That I have knowledge of the facts, statements, and matters herein contained and the log of the above-described well as filed and that the same are true and correct. So help me God.

(Signature) Betty Brandt
910 Union Center, Wichita, Kansas 67202
(Address)

SUBSCRIBED AND SWORN TO before me this 28th day of July, 19 81

Rebecca L. Matthews
Rebecca L. Matthews Notary Public.

My commission expires May 17, 1983.

RECEIVED
STATE CORPORATION COMMISSION

III 291981

CONSERVATION DIVISION
Wichita, Kansas

R O T A R Y D R I L L E R S ' L O G

OPERATOR: Aylward Drilling Company DRILLING COMMENCED: July 7, 1981
909 First National Bank Building
Wichita, Kansas 67202

CONTRACTOR: Graves Drilling Co., Inc. DRILLING COMPLETED: July 15, 1981
910 Union Center
Wichita, Kansas 67202

CASING RECORD: 10 Jts. 410' of new 8-5/8" LOCATION: Krehbiel No. 1
cemented with 290 sacks. NE SE NE
Section 14-32S-12W
Barber County, Kansas

0 - 486 Red bed
486 - 1410 Red rock
1410 1886 Shale
1886 - 4276 Shale & lime
4276 - 4350 Lime
4350 Rotary Total Depth

I hereby certify the foregoing statements to be true and correct to the best of my knowledge.

Copy sent to:
State Corporation Commission
Kansas Geological Society
Kansas Geological Survey

GRAVES DRILLING CO., INC.

By Rebecca L. Matthews
Secretary-Treasurer

STATE OF KANSAS)
) ss:
SEDGWICK COUNTY)

Subscribed and sworn to before me, a Notary Public this 28th day of July, 1981.

Rebecca L. Matthews
Rebecca L. Matthews Notary Public

My commission expires: May 17, 1983.