

STATE OF KANSAS
STATE CORPORATION COMMISSION


WELL PLUGGING RECORD

Give All Information Completely
Make Required Affidavit
Mail of Deliver Report to:
Conservation Division
State Corporation Commission
211 No. Broadway
Wichita, Kansas

Barber County, Sec. 13 Twp. 31 Rge. 13 (E) W (W)

Location as "NE/CNW/SW" or footage from lines C SE NW/4
Lease Owner John R. LeBosquet
Lease Name Maddix #1 Well No. _____
Office Address Wichita, Kansas
Character of Well (completed as Oil, Gas or Dry Hole) _____
Date well completed _____ 19____
Application for plugging filed _____ 19____
Application for plugging approved _____ 19____
Plugging commenced 1-27-58 19____
Plugging completed 1-31-58 19____
Reason for abandonment of well or producing formation _____

NORTH

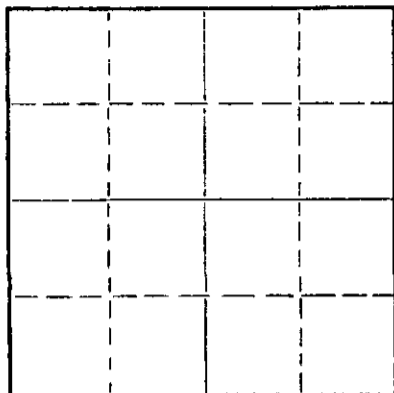

Locate well correctly on above
Section Plat

If a producing well is abandoned, date of last production _____ 19____
Was permission obtained from the Conservation Division or its agents before plugging was commenced? yes

Name of Conservation Agent who supervised plugging of this well W.L. Lackamp
Producing formation _____ Depth to top _____ Bottom _____ Total Depth of Well 3546' Feet
Show depth and thickness of all water, oil and gas formations.

OIL, GAS OR WATER RECORDS

CASING RECORD

FORMATION	CONTENT	FROM	TO	SIZE	PUT IN	PULLED OUT
				8-5/8"	164'	none
				5-1/2"	3534'	2579'

Describe in detail the manner in which the well was plugged, indicating where the mud fluid was placed and the method or methods used in introducing it into the hole. If cement or other plugs were used, state the character of same and depth placed, from _____ feet to _____ feet for each plug set.

RECEIVED
STATE CORPORATION COMMISSION
FEB 7 1958
CONSERVATION DIVISION
Wichita, Kansas

Checked the hole and found it open. Tried to set plug at 3200', too much pressure. Had Halliburton squeeze 35 sacks of cement at 3250'. Pumped plug to 3250'. Pulled 40 jts of casing and had Globe Cementing Company pump 63 sacks of mud into casing. Pulled rest of casing, cleared hole and checked mud to 115'. Bailed mud to 245', set a 10' rock bridge and ran 30 sacks of cement. Mudded the hole to 30', set a rock bridge and ran 10 sacks of cement to base of cellar.

(If additional description is necessary, use BACK of this sheet)
Name of Plugging Contractor West Supply Co., Inc.
Address Chase, Kansas

STATE OF KANSAS COUNTY OF RICE, ss.
John R. LeBosquet (Operator) (employee of owner) or (owner or operator) of the above-described well, being first duly sworn on oath, says: That I have knowledge of the facts, statements, and matters herein contained and the log of the above-described well as filed and that the same are true and correct. So help me (God).

(Signature) [Signature]
722-725 Union Center, Wichita 2, Kansas
(Address)

SUBSCRIBED AND SWORN TO before me this 4th day of February, 19 58
Thomas V. Duggan
Notary Public.

My commission expires 9-27-58

PLUGGING
FILE SEC 13 T. 31 R. 13
BOOK PAGE 28 LINE 6


WELL LOG BUREAU—KANSAS GEOLOGICAL SOCIETY
 503 East Murdock, Wichita, Kansas

COPY

Company- FRONTIER OIL CO...
 Farm- Maddix No. 1

SEC. 13 T. 31 R. 13W
 C SE NW/4

Total Depth. 3546'
 Comm. 5-14-54 Comp. 5-23-54
 Shot or Treated.
 Contractor.
 Issued. 8-14-54

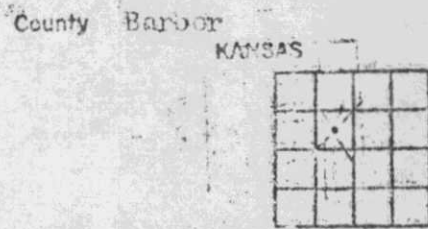

Elevation. 1589'
 Production. 1,096,000 gas

CASING:

8 5/8" 164' con w/175 sx
 5 1/2" 3534' con w/125 sx

Figures indicate Bottom of Formations.

shale	120
sand	135
shale & shells	164
shale	514
shale & shells	1540
lime & shale	1815
shale & shells	2146
lime	2475
lime & shale	2509
shale & shells	2849
lime	3058
shale & shells	3172
shale	3286
shale & shells	3513
shale	3546 RTD
Total Depth	

Tops:

Heebner	3164
Douglas Sand	3536

RECEIVED
 ST. T. CORPORATION COMMISSION
 JAN 23 1958
 CON. ERVATION DIVISION
 Wichita, Kansas

PLUGGING
 FILE SEC 13 T 31 R 13W
 BOOK PAGE 78 LINE 6