


WELL PLUGGING RECORD

Give All Information Completely  
Make Required Affidavit  
Mail or Deliver Report to:  
Conservation Division  
State Corporation Commission  
211 No. Broadway  
Wichita, Kansas

NORTH

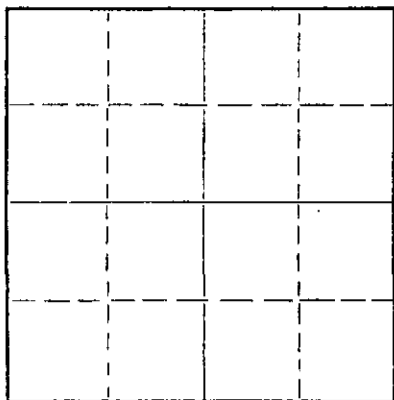

Locate well correctly on above Section Plat

Barber County, Sec. 14 Twp. 32S Rge. 12 (W)  
Location as "NE/CNW%SW%" or footage from lines SE SE NW  
Lease Owner E. H. Adair Oil Company, et al.  
Lease Name Adams Well No. 1.  
Office Address 1017 East Second Street, Wichita 7, Kansas.  
Character of Well (completed as Oil, Gas or Dry Hole) Dry-hole.  
Date well completed 4/10 19 56  
Application for plugging filed 4/11 19 56  
Application for plugging approved 4/11 19 56  
Plugging commenced 4/11 19 56  
Plugging completed 4/11 19 56  
Reason for abandonment of well or producing formation Dry-hole.

If a producing well is abandoned, date of last production \_\_\_\_\_ 19 \_\_\_\_  
Was permission obtained from the Conservation Division or its agents before plugging was commenced? Yes.

Name of Conservation Agent who supervised plugging of this well M.A. Rives, Box 8, Pratt, Kansas.  
Producing formation \_\_\_\_\_ Depth to top \_\_\_\_\_ Bottom \_\_\_\_\_ Total Depth of Well 4720 Feet  
Show depth and thickness of all water, oil and gas formations.

OIL, GAS OR WATER RECORDS

CASING RECORD

| FORMATION                               | CONTENT | FROM | TO | SIZE | PUT IN | PULLED OUT |
|---|---------|------|----|------|--------|------------|
| (Copy of driller's log attached hereto) |         |      |    |      |        |            |
|   |         |      |    |      |        |            |
|   |         |      |    |      |        |            |
Describe in detail the manner in which the well was plugged, indicating where the mud fluid was placed and the method or methods used in introducing it into the hole. If cement or other plugs were used, state the character of same and depth placed, from \_\_\_\_\_ feet to \_\_\_\_\_ feet for each plug set.

Run bottom plug at 160 feet with 20 sacks of cement.  
Run top plug at 35 feet with 10 sacks of cement. Filled to surface with dirt and sand.

(If additional description is necessary, use BACK of this sheet)

Name of Plugging Contractor E. H. Adair Oil Company  
Address 1017 East Second Street, Wichita 7, Kansas.

STATE OF KANSAS, COUNTY OF SEDGWICK, ss.  
K. W. Johnson (employee of owner) or (owner or operator) of the above-described well, being first duly sworn on oath, says: That I have knowledge of the facts, statements, and matters herein contained and the log of the above-described well as filed and that the same are true and correct. So help me God.

(Signature) [Signature]  
1017 E. Second Street  
(Address)

SUBSCRIBED AND SWORN TO before me this 16th day of April, 19 56

My commission expires Sept. 15, 1957.

[Signature]  
L. Hill Notary Public.

**PLUGGING**  
FILE SEC 14 T 32 R 12W  
BOOK PAGE 53 LINE 6

4-19-56

E. H. Adair Oil Company  
Wichita 7, Kansas.

E. H. Adair Oil Company, et al  
No. 1 Adams  
Approx. SE SE NW of  
Sec. 14, 32S., 12 W.  
Barber County, Kansas.  
450 ft. from East line and  
330 ft. from South line of NW/4.

Comm.: 3-20-56  
Comp.: 4-10-56  
Contractor:  
Adair - Rig No. 1.  
8-5/8 @ 161 feet w/150 sx.  
Pro. D. & A.

Elev. 1508 K.B., 3 feet above  
D.F., 9 feet above ground.

Figures indicate bottoms of Formations

|                |    |      |             |    |      |
|----------------|----|------|-------------|----|------|
| Redrock        | to | 130  | Sandy lime  | to | 3688 |
| Shale & shells |    | 1484 | Sandy shale |    | 3754 |
| Shale & lime   |    | 1800 | Lime        |    | 3758 |
| Lime           |    | 1870 | Shale       |    | 3762 |
| Lime & shale   |    | 3000 | Lime        |    | 4338 |
| Lime           |    | 3043 | Chert       |    | 4394 |
| Shaley lime    |    | 3215 | Cherty lime |    | 4506 |
| Shale          |    | 3350 | Shale       |    | 4587 |
| Lime           |    | 3392 | Black shale |    | 4623 |
| Sandy shale    |    | 3527 | Cherty lime |    | 4704 |
| Shaley lime    |    | 3589 | Shale       |    | 4709 |
| Sandy shale    |    | 3657 | Sand        |    | 4722 |

Certified correct:

*K. W. Johnson*  
K. W. Johnson - Geologist.

RECEIVED  
REGION  
ADVISOR  
REGION

**PLUGGING**  
FILE SEC 14 T 32 B 12W  
BOOK PAGE 53 LINE 6