


STATE OF KANSAS
STATE CORPORATION COMMISSION
200 Colorado Derby Bldg.
Wichita, Kansas 67202

Form CP-4
Rev. 12-15-80

WELL PLUGGING RECORD

Give All Information Completely
Make Required Affidavit

COUNTY Barber SEC. 14 TWP. 32S RGE. 12W 1/4
Location as in quarters or footage from lines:
990' FSL & 1650' FWL NW SE SW

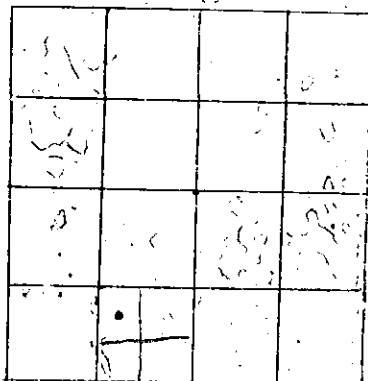

Locate Well
correctly on above
Section Platt.

Lease Owner The Maurice L. Brown Company
Lease Name Vanderwork A Well No. 1
Office Address 200 Sutton Building, Wichita, Kansas 67202
Character of Well (Completed as Oil, Gas or Dry Hole): Dry Hole
Date Well Completed 3-10-81
Application for plugging filed 3-10-81 - verbal
Plugging commenced 3-10-81
Plugging completed 3-10-81
Reason for abandonment of well or producing formation Dry Hole

Was permission obtained from the Conservation Division or it's
Agent's before plugging was commenced? Yes

Name of Conservation Agent who supervised plugging of this well Maurice Leslie
Producing formation _____ Depth to top _____ bottom _____ T.D. _____
Show depth and thickness of all water, oil and gas formations.

OIL, GAS OR WATER RECORDS

Casing Record

Formation	Content	From	To	Size	Put in	Pulled Out

Describe in detail the manner in which the well was plugged, indicating where the mud
fluid was placed and the method or methods used in introducing it into the hold. If cement
or other plugs were used, state the character of same and depth placed, from _____ feet
to _____ feet for each plug set.

- 1st. plug @ 375' w/35 sx.
- 2nd. plug @ 40' w/15 sx.
- 5 sx. in rathole

(If additional description is necessary, use BACK of this sheet)

Name of Plugging Contractor Gabbert-Jones, Inc. 3-20-81 MAR 20 1981

STATE OF Kansas COUNTY OF Sedgwick, ss.
Vern Hasehorst (employee of owner) or (~~owner or operator~~)

CONSERVATION DIVISION
Wichita, Kansas

above-described well, being first duly sworn on oath, says: That I have knowledge of the
facts, statements, and matters herein contained and the log of the above-described well as
filed and that the same are true and correct. So help me God.

(Signature) Vern Hasehorst
(Address) _____

SUBSCRIBED AND SWORN TO before me this 19th day of March, 19 81

Appointment
My Commission expires: July 29, 1981

Marjorie P. Jennings
Notary Public.