


WELL PLUGGING RECORD

Give All Information Completely  
Make Required Affidavit  
Mail or Deliver Report to:  
Conservation Division  
State Corporation Commission  
211 No. Broadway  
Wichita, Kansas

NORTH

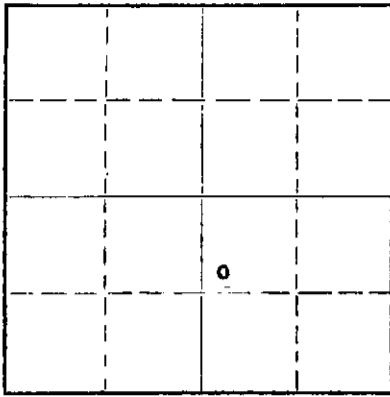

Locate well correctly on above  
Section Plat

BARBER County. Sec. 20 Twp. 30 Rge. (E) 15 (W)  
Location as "NE/CNW&SW" or footage from lines SW NW SE  
Lease Owner ALADDIN PETROLEUM CORPORATION  
Lease Name GYPSUM "A" Well No. 1  
Office Address 809 PETROLEUM BLDG., WICHITA, KANSAS  
Character of Well (completed as Oil, Gas or Dry Hole) OIL  
Date well completed MAY 31 1943  
Application for plugging filed OCT. 9 1958  
Application for plugging approved OCT. 10 1958  
Plugging commenced NOV. 4 1958  
Plugging completed NOV. 13 1958  
Reason for abandonment of well or producing formation NOT PROFITABLE

If a producing well is abandoned, date of last production DECEMBER 1956  
Was permission obtained from the Conservation Division or its agents before plugging was commenced? YES

Name of Conservation Agent who supervised plugging of this well W. L. LAC KAMP, JR.  
Producing formation KANSAS CITY Depth to top 4024 Bottom 4232 Total Depth of Well 4451 Feet  
Show depth and thickness of all water, oil and gas formations.

OIL, GAS OR WATER RECORDS

CASING RECORD

FORMATION	CONTENT	FROM	TO	SIZE	PUT IN	PULLED OUT
LANSING		3877'		13"	165'	NONE
K. C.		4024'				
B/K. C.		4232'		7"	4432'	3196'
FT. SCOTT		4328'				
MAASEY		4338'				
BASAL SAND		4428'				
CONGL.		4450'				

Describe in detail the manner in which the well was plugged, indicating where the mud fluid was placed and the method or methods used in introducing it into the hole. If cement or other plugs were used, state the character of same and depth placed, from \_\_\_\_\_ feet to \_\_\_\_\_ feet for each plug set.

SAND 4350' TO 4310'  
CEMENT 4310' TO 4290'  
MUD 4290' TO 165'  
ROCK 165' TO 155'  
CEMENT 155' TO 125'  
MUD 125' TO 15'  
CEMENT 15' TO 0'

RECEIVED  
STATE CORPORATION COMMISSION  
NOV 21 1958  
CONSERVATION DIVISION  
Wichita, Kansas

(If additional description is necessary, use BACK of this sheet)  
Name of Plugging Contractor GLENN & SMITH PIPE PULLING CO.  
Address Box 114, ELLINWOOD, KANSAS

STATE OF KANSAS, COUNTY OF SEDGWICK, ss.  
J. M. JOHNSON (employee of owner) or (owner or operator) of the above-described well, being first duly sworn on oath, says: That I have knowledge of the facts, statements, and matters herein contained and the log of the above-described well as filed and that the same are true and correct. So help me God.

(Signature) *J. M. Johnson*  
VICE-PRES.  
809 PETROLEUM BLDG., WICHITA, KANS.  
(Address)

SUBSCRIBED AND SWORN TO before me this 20TH day of NOVEMBER, 1958

My commission expires 11-1-61

*Faye English*  
FAYE ENGLISH Notary Public.

PLUGGING  
FILE SEC. 20 T. 30 R. 15W  
BOOK PAGE 135 LINE 31

**COPY**

ALADDIN PETRO. CORP.  
National Gypsum No. 1.

SEC. 20 T. 30 R. 15 W  
SW NW SE

DISCOVERY WELL

Total Depth. 4451'  
Comm. 2-12-43 Comp. 5-12-43  
Shot or Treated.  
Contractor. Mitchell Drils. Co.  
Issued. 6-12-43

County. Barber



CASING:  
13" 165' Com.  
7" 4432'

Elevation.

Production. Phy. Pmp 129 B.

Figures Indicate Bottom of Formations.

soil-gravel, clay rod	115
red bed sand & gravel	300
shale & shells	565
lime & shale	835
shale & lime	930
shale & shells	1650
lime	1075
shale	1820
lime	2133
lime & shale brown	2190
lime shale	2260
lime & chert	2320
lime & shale	2415
lime brkn	2495
lime & shale	2590
shale, lime, shell	2635
lime brkn	2715
lime & shale	2850
lime brkn	2950
lime & shale	3600
lime shale	3710
lime, shale, sand	3740
lime & shale	3850
shale & shells	3900
lime shale	3940
lime	4240
lime shale	4305
shale & lime	4335
lime	4436
lime & sand	4446
coring sand	4451
Total Depth	

**RECEIVED**  
STATE CORPORATION COMMISSION  
NOV 21 1958  
CONSERVATION DIVISION  
Wichita, Kansas

**PLUGGING**  
FILE SEC. 20 T. 30 R. 15W  
BOOK PAGE 135 LINE 31