


STATE OF KANSAS
STATE CORPORATION COMMISSION

WELL PLUGGING RECORD

Give All Information Completely
Make Required Affidavit
Mail or Deliver Report to:
Conservation Division
State Corporation Commission
800 Bitting Building
Wichita, Kansas

NORTH

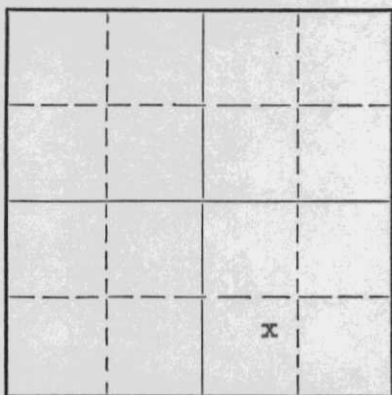

Locate well correctly on above
Section Plat

Barber County, Sec. 20 Twp. 30S Rge. 15W (E) (W)
Location as "NE/CNW $\frac{1}{4}$ SW $\frac{1}{4}$ " or footage from lines Center NE SW SE
Lease Owner Coronado Oil Company
Lease Name Lizzie Tucker Well No. 1-A
Office Address 607 National Bank of Tulsa Bldg., Tulsa 3, Oklahoma
Character of Well (completed as Oil, Gas or Dry Hole) Dry Hole
Date well completed June 25 19 51
Application for plugging filed June 30 19 51
Application for plugging approved June 30 19 51
Plugging commenced June 30 19 51
Plugging completed June 30 19 51
Reason for abandonment of well or producing formation Dry Hole

If a producing well is abandoned, date of last production No production 19
Was permission obtained from the Conservation Division or its agents before plugging was commenced? Yes

Name of Conservation Agent who supervised plugging of this well M. A. Rivas
Producing formation None Depth to top Bottom Total Depth of Well 4436 Feet
Show depth and thickness of all water, oil and gas formations.

OIL, GAS OR WATER RECORDS

CASING RECORD

Formation	Content	From	To	Size	Put In	Pulled Out
No oil or gas shows				12-3/4"	155	None

RECEIVED
STATE CORPORATION COMMISSION
JUL - 5 1951
CONSERVATION DIVISION
Wichita, Kansas

Describe in detail the manner in which the well was plugged, indicating where the mud fluid was placed and the method or methods used in introducing it into the hole. If cement or other plugs were used, state the character of same and depth placed, from 150 feet to 112 feet for each plug set. From 25 feet to 5 feet.

With drill pipe on bottom, the hole was circulated with heavy mud. After pulling drill pipe, the hole was filled with heavy mud to 150 feet. A wooden plug was driven to 150 feet and a 25 sack cement plug was placed on top of the wooden plug from 150 feet back to 112 feet. The hole was then filled with mud to 25 feet and a 15 sack cement plug was placed from 25 feet back to 5 feet. The surface casing was cut off 5 feet below ground level.

(If additional description is necessary, use BACK of this sheet)

Correspondence regarding this well should be addressed to Coronado Oil Company
Address 607 National Bank of Tulsa Building, Tulsa 3, Oklahoma

STATE OF OKLAHOMA, COUNTY OF TULSA, ss.
I. A. PARMER (employee of owner) or (owner or operator)

being first duly sworn on oath, says: That I have knowledge of the facts, statements, and matters herein contained and the log of the above-described well as filed and that the same are true and correct. So help me God.

(Signature) *I. A. Parmer* Div. Supt.
607 Nat'l Bank of Tulsa Bldg., Tulsa, Okla.
(Address)

SUBSCRIBED AND SWORN to before me this 3rd day of July, 1951.

My commission expires March 31, 1954
W. J. Jackson
Notary Public.

PLUGGING
FILE SEC 20 T 30 R 15W
BOOK PAGE 91 LINE 34

WELL RECORD

Coronado Oil Company Lizzie Tucker No. 1-A, NE/4 SW/4 SE/4, Sec. 20-T30S-R15W, Barber County, Kansas.

Commenced: 6-4-51 Completed: 6-25-51

Sand	0	110
Redbed	110	170
Redbed, Shale	170	400
Redbed, Shale, Shells, Lime	400	808
Shale, Lime, Shells	808	1071
Redbed	1071	1320
Shale, Lime, Shells	1320	1744
Lime, Shale	1744	1945
Lime	1945	1965
Lime, Shale	1965	2045
Lime	2045	2185
Lime, Shale	2185	2285
Lime	2285	2376
Lime, Shale	2376	2472
Lime	2472	2781
Lime, Shale	2781	3090
Sand, Lime	3090	3190
Shale, Lime	3190	3306
Lime	3306	3357
Lime, Sand	3357	3502
Lime	3502	3781
Lime, Sand	3781	3860
Lime, Shale	3860	3943
Lime	3943	4362
Lime, Chert	4362	4405
Sand	4405	4430
Lime	4430	4436 T.D.

PLUGGING
FILE SEC. 20 T 30 R 15 W
BOOK PAGE 91 LINE 34

RECEIVED
STATE CORPORATION COMMISSION
JUL - 5 1951
CONSERVATION DIVISION
Wichita, Kansas