


WELL PLUGGING RECORD

Give All Information Completely
Make Required Affidavit
Mail or Deliver Report to:
Conservation Division
State Corporation Commission
211 No. Broadway
Wichita, Kansas

NORTH

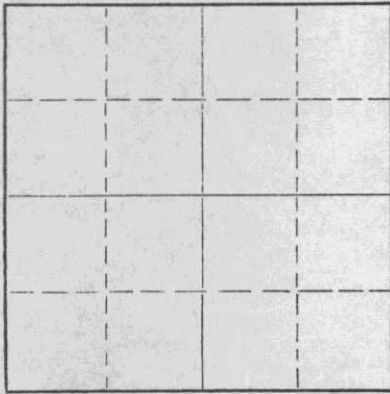

Locate well correctly on above
Section Plat

Barber County. Sec. 29 Twp. 31S Rge. 12(W)
Location as "NE/CNW/SW" or footage from lines SE/NE/sw
Lease Owner Anschutz Drilling Co., Inc.
Lease Name Frieden Well No. 1
Office Address 709 Union Nat'l Bank Bldg., Wichita, Kansas
Character of Well (completed as Oil, Gas or Dry Hole) Dry Hole
Date well completed 10-5-56 19
Application for plugging filed 10-4-56 19
Application for plugging approved 10-4-56 19
Plugging commenced 10-4-56 19
Plugging completed 10-4-56 19
Reason for abandonment of well or producing formation Dry Hole

If a producing well is abandoned, date of last production _____ 19____
Was permission obtained from the Conservation Division or its agents before plugging was commenced? Yes

Name of Conservation Agent who supervised plugging of this well M. A. Rives, Box 8, Pratt, Kansas
Producing formation _____ Depth to top _____ Bottom _____ Total Depth of Well 4,290 Feet
Show depth and thickness of all water, oil and gas formations.

OIL, GAS OR WATER RECORDS

CASING RECORD

FORMATION	CONTENT	FROM	TO	SIZE	PUT IN	PULLED OUT
<u>Clay, Rim Rock, Sand & Red Bed</u>		<u>0*</u>	<u>215*</u>	<u>8 5/8"</u>	<u>220*</u>	<u>0*</u>

Describe in detail the manner in which the well was plugged, indicating where the mud fluid was placed and the method or methods used in introducing it into the hole. If cement or other plugs were used, state the character of same and depth placed, from _____ feet to _____ feet for each plug set.

Hole plugged at 6 P.M. 10-4-56, bottom plug @ 200* W/20 sacks cement, hole filled with heavy mud to 35*, top plug @ 35* W/10 sacks cement.

(If additional description is necessary, use BACK of this sheet)


Name of Plugging Contractor Graham-Michaelis Drilling Co.
Address 1005 East Second Street, Wichita, Kansas

STATE OF Kansas, COUNTY OF Sedgwick, ss.
V. D. Grier (employee of owner) or (~~owner or operator~~) of the above-described well, being first duly sworn on oath, says: That I have knowledge of the facts, statements, and matters herein contained and the log of the above-described well as filed and that the same are true and correct. So help me God. Graham-Michaelis Drilling Co.

(Signature) V. D. Grier
1005 East Second Street, Wichita, Kansas
(Address)

SUBSCRIBED AND SWORN TO before me this 10th day of October, 1956

My commission expires 11/7/57

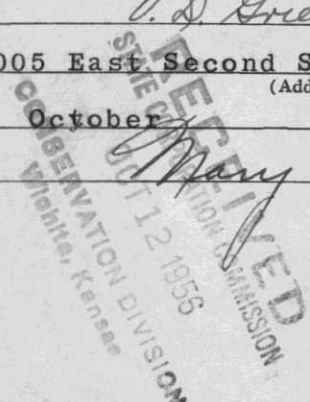

PLUGGING
FILE SEC. 29 T. 31 R. 12W
BOOK PAGE 105 LINE 19

FRIEDEN #1

Well Record

Location: Section 29-31S-12W
Barber County, Kansas

Operator: Anschutz Drilling Co., Inc.
709 Union National Bank Building
Wichita, Kansas

Contractor: Graham-Michaelis Drilling Co.
1005 East Second Street
Wichita 1, Kansas

Casing Record: 8-5/8" @ 215' W/150 sacks cement

Commenced: September 21, 1956
Completed: October 5, 1956
(rotary)

	<u>LOG</u>
Clay, Rim Rock & Sand	70
Red Bed	998
Anhydrite	1028
Shale & Shells	1480
Shale & Lime	3552
Lime, Shale & Sand	3650
Lime & Shale	3732
Lime	4238
Lime & Chert.	4290, RTD.

STATE OF KANSAS)
) ss.
COUNTY OF SEDGWICK)

The undersigned, GRAHAM-MICHAELIS DRILLING COMPANY, hereby certifies that the above log is a true and correct log of the formations encountered in drilling the above well as reflected by the Daily Drilling Report.

GRAHAM-MICHAELIS DRILLING CO.

By John L. James
John L. James
Geologist.

Subscribed and sworn to before me
this 9th day of October, 1956.

Mary L. Barnes

My commission expires: 11/7/57.

PLUGGING
FILE SEC 29 T 31 R 12W
BOOK PAGE 105 LINE 19

RECEIVED
OCT 12 1956
REGISTRATION DIVISION
Wichita, Kansas
10-12-56