

STATE OF KANSAS
STATE CORPORATION COMMISSION


Form CP-4

Give All Information Completely
Make Required Affidavit
Mail or Deliver Report to:
Conservation Division
State Corporation Commission
212 No. Market
Wichita, Kansas 67202

WELL PLUGGING RECORD

Barber County, Sec. 16 Twp. 34S Rge. 11 XX (W)
Location as "NE/CNW/SW" or footage from lines C SE NW
Lease Owner Nichols Drilling Company
Lease Name Landis Well No. 1-16
Office Address 811 Cravens Building, Oklahoma City, Oklahoma 73102
Character of Well (completed as Oil, Gas or Dry Hole) Dry Hole
Date well completed November 13, 1969
Application for plugging filed November 17, 1969
Application for plugging approved November 13, 1969
Plugging commenced November 13, 1969
Plugging completed November 13, 1969
Reason for abandonment of well or producing formation Dry Hole

NORTH

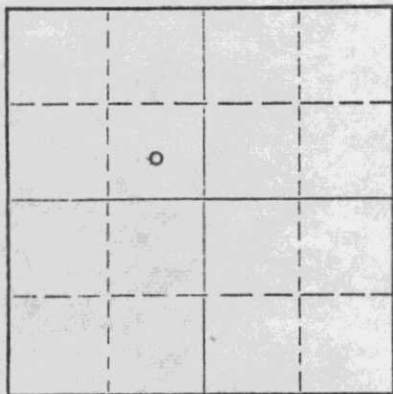

Locate well correctly on above Section Plat

If a producing well is abandoned, date of last production - - - 19
Was permission obtained from the Conservation Division or its agents before plugging was commenced? Yes

Name of Conservation Agent who supervised plugging of this well Ralph J. Warren, Pratt, Kansas
Producing formation - - - Depth to top - - Bottom - - Total Depth of Well 4620 Feet
Show depth and thickness of all water, oil and gas formations.

OIL, GAS OR WATER RECORDS

CASING RECORD

FORMATION	CONTENT	FROM	TO	SIZE	PUT IN	PULLED OUT
				8-5/8"	325.70'	NONE
				Cemented	W/250 sacks.	

Describe in detail the manner in which the well was plugged, indicating where the mud fluid was placed and the method or methods used in introducing it into the hole. If cement or other plugs were used, state the character of same and depth placed, from _____ feet to _____ feet for each plug set.

Filled hole with heavy mud to 320', put in 1/2 sack hulls, cemented bottom of surface casing with 30 sacks. Filled surface casing to 40' with heavy mud, put in 1/2 sack hulls, and cemented top of surface casing with 15 sacks. Cemented rat hole with 5 sacks.

RECEIVED
STATE CORPORATION COMMISSION
DEC 1 1969
CONSERVATION DIVISION
Wichita, Kansas

(If additional description is necessary, use BACK of this sheet)

Name of Plugging Contractor _____
Address _____

STATE OF Oklahoma, COUNTY OF Stephens, ss.
James Wagenseller (employee of owner) or (owner or operator) of the above-described well, being first duly sworn on oath, says: That I have knowledge of the facts, statements, and matters herein contained and the log of the above-described well as filed and that the same are true and correct. So help me God.

(Signature) James Wagenseller
811 Cravens Building, Oklahoma City, Oklahoma
(Address)

SUBSCRIBED AND SWORN TO before me this 18th day of November, 1969

My commission expires January 23, 1972.

[Signature] Notary Public.

NICHOLS DRILLING COMPANY

DUNCAN, OKLAHOMA

DRILLERS' WELL LOG

RECEIVED
STATE CORPORATION COMMISSION
DEC 1 1969
CONSERVATION DIVISION
Wichita, Kansas

LANDIS WELL NO. 1-16
SE NW Section 16-34S-11W
Barber County, Kansas

Commenced: November 2, 1969
Completed: November 13, 1969

OPERATOR - Nichols Drilling Company

DEPTH	FORMATION	REMARKS
0	283	Red bed and shale
283	1414	Shale and shells
1414	3172	Shale and lime
3172	3298	Lime
3298	3525	Shale, lime and sand
3525	3916	Shale and lime
3916	4620	Lime

Ran 10 joints 8-5/8" casing, set @ 325.70' with 250 sacks cement.

I, James Wagenseller, certify this is a correct copy of the Drillers' log for the well drilled in the SE NW Section 16-34S-11W, Barber County, Kansas, to the best of my knowledge and belief.

James Wagenseller
James Wagenseller

STATE OF OKLAHOMA)
)
COUNTY OF STEPHENS)

Before me, the undersigned, a Notary Public within and for said County and State, on this 18th day of November 1969, personally appeared James Wagenseller to me personally know to be the identical person who executed the within and foregoing instrument and acknowledged to me that he executed the same as his free and voluntary act and deed for the uses and purposes therein set forth.

IN WITNESS WHEREOF, I have hereunto set my hand and official seal the day and year last above written.

My Commission Expires: Jan. 23, 1972.

Merle S. Draper
Merle S. Draper, Notary Public