


STATE OF KANSAS
STATE CORPORATION COMMISSION

WELL PLUGGING RECORD

Give All Information Completely
Make Required Affidavit
Mail or Deliver Report to:
Conservation Division
State Corporation Commission
800 Bitting Building
Wichita, Kansas

Barber County, Sec. 12 Twp. 34 S Rge. 11 (E) W (W)
Location as "NE/CNW/SW" or footage from lines. C SW NW
Lease Owner Mull Drilling Co. Inc.
Lease Name Circle Well No. 1
Office Address 670 N. 4th. Natl Bank Bldg. Wichita, Kansas
Character of Well (completed as Oil, Gas or Dry Hole) Dry Hole
Date well completed 4-4 1960
Application for plugging filed 4-21 1960
Application for plugging approved 4-21 1960
Plugging commenced 4-21 1960
Plugging completed 4-23 1960
Reason for abandonment of well or producing formation Dry in Miss.

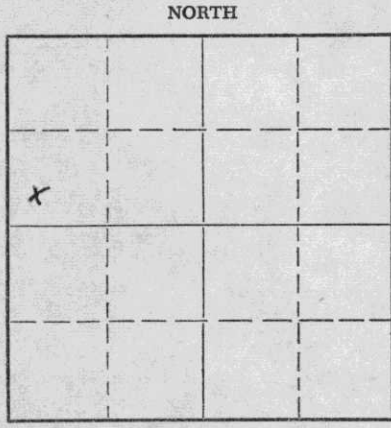

Locate well correctly on above
Section Plat

If a producing well is abandoned, date of last production _____ 19____
Was permission obtained from the Conservation Division or its agents before plugging was commenced? Yes

Name of Conservation Agent who supervised plugging of this well Fred W. Hampel
Producing formation None Depth to top _____ Bottom _____ Total Depth of Well 4628 Feet
Show depth and thickness of all water, oil and gas formations.

OIL, GAS OR WATER RECORDS

CASING RECORD

FORMATION	CONTENT	FROM	TO	SIZE	PUT IN	PULLED OUT
					4628	
						3760

Describe in detail the manner in which the well was plugged, indicating where the mud fluid was placed and the method or methods used in introducing it into the hole. If cement or other plugs were used, state the character of same and depth placed, from _____ feet to _____ feet for each plug set.

Sanded bottom of hole from 4545' to 4575'. Put 4 sacks cement on top of sand.
Hole mudded to within 190' of top, set a 10' rock bridge at this depth and added 20 sacks cement. Hole then filled with mud to within 35' of top, set a rock bridge at this depth and put 10 sacks cement in hole filling same to within 4' of top of ground level. This completed plugging of hole.

RECEIVED
STATE CORPORATION COMMISSION
APR 27 1960
CONSERVATION DIVISION
Wichita, Kansas

(If additional description is necessary, use BACK of this sheet)

Name of Plugging Contractor Co. Tools.
Address 670 N. 4th. Natl. Bank Bldg. Wichita, Kansas

STATE OF Kansas, COUNTY OF Sedgwick, ss.
Joseph O. Butts (employee of owner) or (owner or operator) of the above-described well, being first duly sworn on oath, says: That I have knowledge of the facts, statements, and matters herein contained and the log of the above-described well as filed and that the same are true and correct. So help me God.

(Signature) Joseph O. Butts
(Address) _____

SUBSCRIBED AND SWORN TO before me this 25th day of April, 19 60

My commission expires January 28, 1961.
Ethel Zimmerman Notary Public.

ROTARY DRILLERS LOG

COMPANY: Mull Drilling Co., Inc. Et Al
Wichita, Kansas

ROTARY DRILLING COMMENCED: 3/21/60

CONTRACTOR: Mull Drilling Co., Inc.
Wichita, Kansas

ROTARY DRILLING COMPLETED: 4/3/60

CASING RECORD: Set 240' of 8 5/8" csg.
cmt. w/150 sax cmt.
Set 5 1/2" @ 4628' cmt.
w/100 sax cmt.
D & (Plugged)

LOCATION: CIRCLE #1
C SW NW 12-34S-11W
Barber County, Kansas

(Figures indicate bottom of formation - measurements from top of Rotary Bushing)

600'	Red Bed	
1400'	Shale & Shells	
3082'	Lime & Shale	
4156'	Sandy Lime & Shale	
4340'	Lime	
4541'	Lime w/Shale	
4595'	Lime	
4628'	Mississippi	- Total Depth

RECEIVED
STATE CORPORATION COMMISSION
APR 27 1960
CONSERVATION DIVISION
Wichita, Kansas

I hereby certify that this is a true and correct copy of the above log to the best of my knowledge.

MULL DRILLING COMPANY, INC.

R. James Gear
R. JAMES GEAR

STATE OF KANSAS)
) SS
COUNTY OF SEDGWICK)

Subscribed and sworn to before me this 14th day of April, 1960



Madge K. Miller
Madge K. Miller, Notary Public

My Commission Expires: February 24, 1964