


WELL PLUGGING RECORD

Give All Information Completely  
Make Required Affidavit  
Mail or Deliver Report to:  
Conservation Division  
State Corporation Commission  
211 No. Broadway  
Wichita, Kansas

NORTH

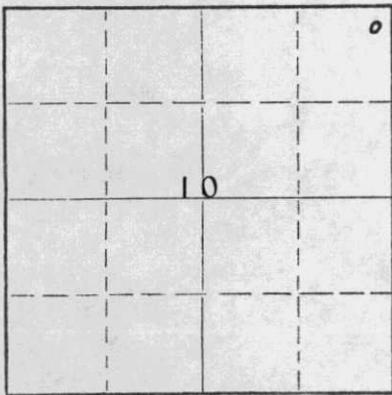

Locate well correctly on above  
Section Plat

Barber County. Sec. 10 Twp. 34S Rge. 11W (E) (W)  
Location as "NE/CNW/SW" or footage from lines NE NE NE  
Lease Owner APPIETON OIL COMPANY (NOT INC)  
Lease Name SCHIBBACH Well No. 2  
Office Address 506 Beacon Building--Tulsa, Oklahoma  
Character of Well (completed as Oil, Gas or Dry Hole) Oil  
Date well completed January 19, 1966 19 66  
Application for plugging filed October 5, 19 66  
Application for plugging approved October 6, 19 66  
Plugging commenced October 5, 19 66  
Plugging completed October 8 at 12:30 19 66  
Reason for abandonment of well or producing formation Non productive

If a producing well is abandoned, date of last production May 1 19 66  
Was permission obtained from the Conservation Division or its agents before plugging was commenced? Yes

Name of Conservation Agent who supervised plugging of this well Archie Elving  
Producing formation Mississippi Chat Depth to top 4550 Bottom 4660 Total Depth of Well 4660 Feet  
Show depth and thickness of all water, oil and gas formations.

OIL, GAS OR WATER RECORDS

CASING RECORD

FORMATION	CONTENT	FROM	TO	SIZE	PUT IN	PULLED OUT
<u>Redrill</u>				<u>8 5/8"</u>	<u>355'</u>	<u>NONE</u>
				<u>4 1/2"</u>	<u>4658'</u>	<u>4100'</u>

Describe in detail the manner in which the well was plugged, indicating where the mud fluid was placed and the method or methods used in introducing it into the hole. If cement or other plugs were used, state the character of same and depth placed, from \_\_\_\_\_ feet to \_\_\_\_\_ feet for each plug set.

Dump Chat plug well from 4630 to 4400  
Then dump three(3) sacks of cement from 4400 to 4365

Ripped pipe off at 4300. Could not pull  
Ripped pipe at 4100 and recovered 4100 feet 4 1/2" pipe  
Plugged well with wood bridge at 300  
Rock ten (10) foot From 300 to 290  
Cement twenty-five (25) sacks from 290 to 215  
Mud From 215 to 40  
Rock ten (10) foot From 40 to 30  
Cement ten (10) sacks From 30 to top

RECEIVED  
STATE CORPORATION COMMISSION  
OCT 19 1966

WELL PLUGGED

CONSERVATION DIVISION  
Wichita, Kansas

(If additional description is necessary, use BACK of this sheet)

Name of Plugging Contractor Clarke Corporation  
Address Box 187--Medicine Lodge, Kansas

STATE OF Oklahoma, COUNTY OF Tulsa, ss.  
A. J. Carey (employee of owner) or (owner or operator) of the above-described well, being first duly sworn on oath, says: That I have knowledge of the facts, statements, and matters herein contained and the log of the above-described well as filed and that the same are true and correct. So help me God.

(Signature) A. J. Carey  
506 Beacon Bldg, Tulsa, Oklahoma  
(Address)

SUBSCRIBED AND SWORN TO before me this 18 day of October, 1966

My commission expires Jan. 3, 1968

Marion J. Moeller  
Notary Public.

OCT 18 1966