


STATE OF KANSAS
STATE CORPORATION COMMISSION

Form CP-4

WELL PLUGGING RECORD

Give All Information Completely
Make Required Affidavit
Mail or Deliver Report to:
Conservation Division
State Corporation Commission
211 No. Broadway
Wichita, Kansas

Barber County. Sec. 10 Twp. 34S Rge. 11W (E) (W)
Location as "NE/CNW/SW" or footage from lines NE SE NE
Lease Owner Appleton Oil Company
Lease Name Schupbach Well No. 1
Office Address 506 Beacon Building, Tulsa, Oklahoma
Character of Well (completed as Oil, Gas or Dry Hole) Dry
Date well completed June 12 19 65
Application for plugging filed June 12 19 65
Application for plugging approved June 12 19 65
Plugging commenced June 12 19 65
Plugging completed June 12 19 65
Reason for abandonment of well or producing formation Dry

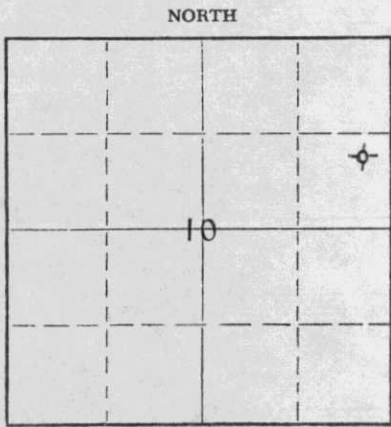

Locate well correctly on above Section Plat

If a producing well is abandoned, date of last production 19
Was permission obtained from the Conservation Division or its agents before plugging was commenced? Yes

Name of Conservation Agent who supervised plugging of this well Archie V. Elving
Producing formation None Depth to top Bottom Total Depth of Well 4650 Feet
Show depth and thickness of all water, oil and gas formations.

OIL, GAS OR WATER RECORDS

CASING RECORD

FORMATION	CONTENT	FROM	TO	SIZE	PUT IN	PULLED OUT
Base Anhydrite	--	1100	1750	8 5/8"	345'	None
Lansing Lime	S.W.	4133	4500			
Mississippi	Dry	4559	4650			

Describe in detail the manner in which the well was plugged, indicating where the mud fluid was placed and the method or methods used in introducing it into the hole. If cement or other plugs were used, state the character of same and depth placed, from feet to feet for each plug set.

Hole full Drilling Mud to 300 feet.
Build Bridge w/2 sx cement - 1/2 sx Hull. Pushed
Halliburton 8 5/8" plug to top of hulls with drill pipe.
25 sx cement dumped on top of Plug. Filled hole with
Mud to 40 feet. Build Bridge w/2 sx cement, 1/2 sx hulls.
Pushed 8 5/8" Halliburton plug to top of Hulls w/Kelley.
Dumped 10 sx cement on top of Plug. Put 2 sx cement in top
of Rat Hole.

RECEIVED
STATE CORPORATION COMMISSION

JUN 15 1965

CONSERVATION DIVISION
Wichita, Kansas

(If additional description is necessary, use BACK of this sheet)

Name of Plugging Contractor Curt Brown Drilling Company
Address Mayo Building, Tulsa, Oklahoma

STATE OF Oklahoma, COUNTY OF Tulsa, ss.
Robert O. Rogers (employee of owner) or (owner or operator) of the above-described well, being first duly sworn on oath, says: That I have knowledge of the facts, statements, and matters herein contained and the log of the above-described well as filed and that the same are true and correct. So help me God.

(Signature) Robert O. Rogers
506 Beacon Building, Tulsa, Oklahoma (Address)

SUBSCRIBED AND SWORN TO before me this 14 day of June, 1965
Sharon J. Moeller Notary Public.

My Commission Expires Jan. 3, 1968
My commission expires

WELL LOG

COMPANY: Appleton Oil Company
CONTRACTOR: Curt Brown Drilling Company
FARM: Schupbach
LOCATION: NE SE NE Sec. 10-T34S-R11W,
Barber County, Kansas
COMMENCED: June 4, 1965
COMPLETED: June 12, 1965
ELEVATION: GL 1366
KB 1373

0 - 1345	Red Beds & Shale
1345 - 1750	Anhydrite & Lime
1750 - 2255	Lime & Shale
2250 - 2435	Lime & Shale
2435 - 2685	Shale w/Lime Streaks
2685 - 4133	Shale & Sand w/Lime Streaks
4133 - 4524	Lansing - KC Lime
4524 - 4559	Cherokee Zone - Shale
4559 - 4650	Mississippian - Chert
4650	T. D.

STATE OF OKLAHOMA)
COUNTY OF TULSA) SS

I, M. F. Moeller, do hereby certify that the above and fore-going is a true and correct copy of the log of the Schupbach #1, located NE SE NE Section 10-T34S-R11W, Barber County, Kansas, as reflected by the files of the Appleton Oil Company.

M F Moeller

Subscribed and sworn to before me, a Notary Public, in and for Tulsa County, Oklahoma, this 23rd day of June, 1965.

Olive C. Reynolds
Notary Public

May commission expires
OLIVE C. REYNOLDS, Notary Public
My Commission Expires April 24, 1968

RECEIVED
STATE CORPORATION COMMISSION

JUN 24 1965

CONSERVATION DIVISION
Wichita, Kansas