


15-007-30175-0000

STATE OF KANSAS
STATE CORPORATION COMMISSION

WELL PLUGGING RECORD

Give All Information Completely
Make Required Affidavit
Mail or Deliver Report to:
Conservation Division
State Corporation Commission
211 No. Broadway
Wichita, Kansas

Barber County, Sec. 15 Twp. 31S Rge. 11W (E) (W)
Location as "NE/CNW/SW" or footage from lines. c NW SW

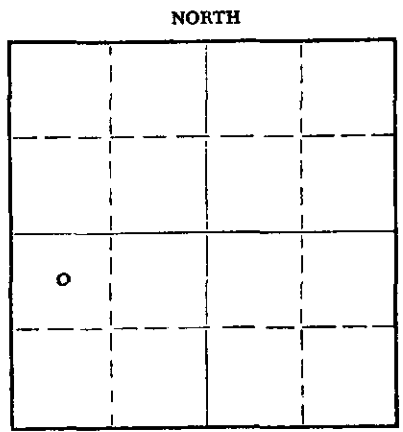

Locate well correctly on above Section Plat

Lease Owner William A. Cecil
Lease Name Smith-Bergner Well No. 1
Office Address 722 Union Center
Character of Well (completed as Oil, Gas or Dry Hole) Dry Hole
Date well completed September 30 19 65
Application for plugging filed September 30 19 65
Application for plugging approved September 30 19 65
Plugging commenced September 30 19 65
Plugging completed September 30 19 65
Reason for abandonment of well or producing formation Dry Hole

If a producing well is abandoned, date of last production 19
Was permission obtained from the Conservation Division or its agents before plugging was commenced? Yes

Name of Conservation Agent who supervised plugging of this well Archie V. Elving, Pratt, Kansas
Producing formation _____ Depth to top _____ Bottom _____ Total Depth of Well 3880 Feet
Show depth and thickness of all water, oil and gas formations.

OIL, GAS OR WATER RECORDS

CASING RECORD

FORMATION	CONTENT	FRDM	TD	SIZE	PUT IN	PULLED OUT
		0	214'	8 5/8"	214'	None

Describe in detail the manner in which the well was plugged, indicating where the mud fluid was placed and the method or methods used in introducing it into the hole. If cement or other plugs were used, state the character of same and depth placed, from _____ feet to _____ feet for each plug set.

Set Plug: 210'/20 sacks cement
Fill up to 155'.

RECEIVED
STATE CORPORATION COMMISSION

OCT 7 1965
10-7-65
CONSERVATION DIVISION
Wichita, Kansas

(If additional description is necessary, use BACK of this sheet)
Name of Plugging Contractor Hellar Drilling Company, Inc.
Address 1014 Union Center, Wichita, Kansas 67202

STATE OF Kansas, COUNTY OF Sedgwick, ss.
D. L. Hellar, Pres. of Hellar Drilling Company, Inc. (employee of owner) or (owner or operator) of the above-described well, being first duly sworn on oath, says: That I have knowledge of the facts, statements, and matters herein contained and the log of the above-described well as filed and that the same are true and correct. So help me God.

(Signature) D. L. Hellar D. L. Hellar, President
1014 Union Center, Wichita, Kansas
(Address)

SUBSCRIBED AND SWORN TO before me this 5th day of October, 19 65

My commission expires March 25, 1968, Catherine Dancy Notary Public.

DRILLER'S LOG

COMPANY: William A. Cecil, Wichita, Kansas
 CONTRACTOR: Hellar Drilling Company, Inc., Wichita, Kansas
 LEASE: #1 Smith-Bergner
 LOCATION: c NW SW 15-31S-11W, Barber County, Kansas
 COMMENCED: September 24, 1965
 COMPLETED: September 30, 1965
 CASING: Set 8 5/8" surface casing @ 214'/215 sacks cement

0-200	Sand and gravel
200-214	Shale
214-512	Shale & Red Bed
512-1512	Red Bed & Shale
1512-1866	Salt Section
1866-2091	Lime & shale
2091-2329	Ft. Riley chert and lime
2329-3130	Lime and shale
3130-3290	Topeka Lime
3290-3370	Lime
3370-3561	Lime and shale
3561-3743	Shale, sand and lime streaks
3743-3832	Shale and lime
3832-3880	Douglas shale and sand
3880	Rotary Total Depth
	D & A

RECEIVED
 STATE CORPORATION COMMISSION

OCT 7 1965
 10-7-65
 CONSERVATION DIVISION
 Wichita, Kansas

STATE OF KANSAS)
) ss
 COUNTY OF SEDGWICK)

I, D. L. Hellar, do hereby certify that the above and foregoing is a true and correct copy of the log of the #1 Smith-Bergner, located in c NW SW 15-31S-11W, Barber County, Kansas, as reflected by the files of the Hellar Drilling Company, Inc.

HELLAR DRILLING COMPANY, INC.

By *D. L. Hellar*
 President - D. L. Hellar

Subscribed and sworn to before me, a Notary Public, in and for Sedgwick County, Kansas, this 5th day of October, 1965.

Catherine Darcey
 Notary Public - Catherine Darcey

My Commission Expires:
 March 25, 1968.