

STATE OF KANSAS
STATE CORPORATION COMMISSION

Give All Information Completely
Make Required Affidavit
Mail or Deliver Report to:
Conservation Division
State Corporation Commission
211 No. Broadway
Wichita, Kansas

WELL PLUGGING RECORD

Barber

County. Sec. 5 Twp. 31 Rge. (E) 15 (W)

Location as "NE/CNW $\frac{1}{4}$ /SW $\frac{1}{4}$ " or footage from lines NE NE NW

Lease Owner Jones, Shelburne & Farmer, Inc.

Lease Name MOAD Well No. 1

Office Address Russell, Kansas

Character of Well (completed as Oil, Gas or Dry Hole) Dry hole

Date well completed 7-7 19 56

Application for plugging filed 7-7 19 56

Application for plugging approved 7-7- 19 56


Plugging commenced 7-7 19 56

Plugging completed 7-7 19 56

Reason for abandonment of well or producing formation Dry

If a producing well is abandoned, date of last production 19

Was permission obtained from the Conservation Division or its agents before plugging was commenced? Yes

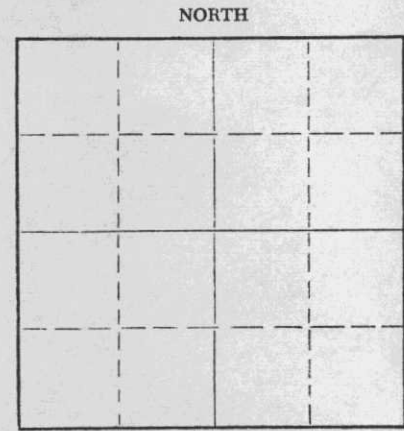

Locate well correctly on above Section Plat

Name of Conservation Agent who supervised plugging of this well M. A. Rives

Producing formation Depth to top Bottom Total Depth of Well 4933 Feet

Show depth and thickness of all water, oil and gas formations. (log)

OIL, GAS OR WATER RECORDS

CASING RECORD

FORMATION	CONTENT	FROM	TO	SIZE	PUT IN	PULLED OUT
				8-5/8	835'	None

Describe in detail the manner in which the well was plugged, indicating where the mud fluid was placed and the method or methods used in introducing it into the hole. If cement or other plugs were used, state the character of same and depth placed, from feet to feet for each plug set.

1. Filled hole with heavy mud to bottom surface pipe
2. Pushed plug to within 5 feet of bottom of surface pipe
3. Pulled drill pipe
4. Dumped in 1/2 sack hulls
5. Ran drill pipe back in and cemented through drill pipe
6. Cemented with 20 sacks on bottom-10 sacks on top
7. Filled hole with mud and then pushed plug to 35 feet
8. Dumped in 1/2 sack hulls
9. Dumped in 10 sacks through drill pipe to fill hole to top

(If additional description is necessary, use BACK of this sheet)

Name of Plugging Contractor Jones, Shelburne & Farmer, Inc.

Address Russell, Kansas

STATE OF Kansas, COUNTY OF Russell, ss.
JOHN O. FARMER

(employee of owner) or (owner or operator) of the above-described well, being first duly sworn on oath, says: That I have knowledge of the facts, statements, and matters herein contained and the log of the above-described well as filed and that the same are true and correct. So help me God.

(Signature)

John O. Farmer

Russell, Kansas

(Address)

SUBSCRIBED AND SWORN TO before me this 11th day of July, 19 56

Lucille Kennedy

Notary Public.

My commission expires 10-11-58

PLUGGING
FILE SEC 5 T 31 R 15W
BOOK PAGE 77 LINE 38

RECEIVED
JUL 18 1956
7-18-56
CONSERVATION DIVISION
Wichita, Kansas


OPERATOR Jones, Shelburne & Farmer, Inc.

FORMATION RECORD

ADDRESS Russell, Kansas

Give detailed description and thickness of all formations drilled through, contents of sand, whether dry, water, oil or gas.

640 Acres
N

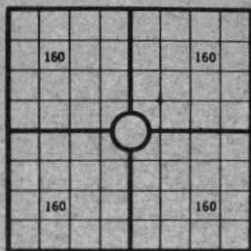

Locate well correctly

COUNTY Barber SEC. 5 TWP. 31 RGE. 15
 COMPANY OPERATING Jones, Shelburne & Farmer, Inc.
 OFFICE ADDRESS Russell, Kansas
 FARM NAME WAXY MOAD WELL NO. 1
 DRILLING STARTED 6-16-56 DRILLING FINISHED 7-7-56
 DATE OF FIRST PRODUCTION _____ COMPLETED _____
 WELL LOCATED NE 1/4 NE 1/4 NW 1/4 North of South
 Line and _____ ft. East of West Line of Quarter Section
 Elevation (Relative to sea level) DERRICK FLOOR 1876 GROUND 1867
 CHARACTER OF WELL (Oil, gas or dryhole) Dry

OIL OR GAS SANDS OR ZONES

Name	From	To	Name	From	To
1			4		
2			5		
3			6		

Perforating Record If Any

Shot Record

Formation	From	To	No. of Shots	Formation	From	To	Size of Shot

CASING RECORD

Amount Set								Amount Pulled		Packer Record	
Size	Wt.	Thds.	Make	Ft.	In.	Ft.	In.	Size	Length	Depth Set	Make
8-5/8				835							

Liner Record: Amount _____ Kind _____ Top _____ Bottom _____

CEMENTING AND MUDDING

Size	Amount Set		Sacks Cement	Chemical		Method of Cementing	Amount	Mudding Method	Results (See Note)
	Ft.	In.		Gal.	Make				
8-5/8	835		350						

Note: What method was used to protect sands if outer strings were pulled?

NOTE: Were bottom hole plugs used? _____ If so, state kind, depth set and results obtained _____

TOOLS USED

Rotary Tools were used from _____ feet to _____ feet. Cable tools were used from _____ feet to _____ feet, and from _____ feet to _____ feet, and from _____ feet to _____ feet.

Type Rig _____

INITIAL PRODUCTION TEST

Describe initial test: whether by flow through tubing or casing or by pumping _____

Amount of Oil Production _____ bbls. Size of choke, if any _____ Length of test _____ Water _____

Production _____ bbls. Gravity of oil _____ Type of Pump if pump is used, describe _____

Formation	Top	Bottom	Formation	Top	Bottom
Surface	0	40			
RedBed & Gyp					
Rock	40	110			
RedBed shale & shells	110	460			
Shale	460	730			
Anhydrite	730	835			
RedBock & shale	835	1040	Elevation RB		1872
Salt Shale & shells	1040	2220	Anhydrite		730
Shale & shells	1220	1410	Electric log tops		
Shale & lime	1410	2020	Heebner		3829
Lime	2020	2800	Douglas		3892
Lime & shale	2800	3405	Brown Lime		4008
Lime	3405	3564	Lansing		4034
Sand & shale	3564	3676	Massey		4470
Lime	3676	3770	Mississippi		4580
Sand	3770	3821	Misner		4641
Lime & shale	3821	3891	Viola		4645
Sand & shale	3891	3978	Simpson		4810
Sandy shale	3978	4040	Arbuckle		4898
Lime	4040	4627	T.D.		4933
Lime (cherty)	4627	4666	D & A		
Lime	4666	4700			
Lime (cherty)	4700	4713			
Lime & chert	4713	4762			
Lime	4762	4836			
Sand & shale	4836	4886			
Arbuckle	4886	4920			
T.D.		4920			

STATE OF KANSAS
 DEPARTMENT OF REVENUE
 DIVISION OF OIL AND GAS
 Russell, Kansas
 7-18-56

PLUGGING
 FILE SEC. 5 T31 R15W
 BOOK PAGE 17 LINE 38

I, the undersigned, being first duly sworn upon oath, state that this well record is true, correct and complete according to the records of this office and to the best of my knowledge and belief.

John D. Farmer - Pres.
 Name and title of representative of company

Subscribed and sworn to before me this 11th day of July 19 56

My Commission expires 10-11-58
Willie Ramsey
 Notary Public

FARM NAME WAXY MOAD WELL NO. 1 COUNTY Barber SEC. 5 TWP. 31 RGE. 15