


WELL PLUGGING RECORD

Give All Information Completely  
Make Required Affidavit  
Mail or Deliver Report to:  
Conservation Division  
State Corporation Commission  
800 Biting Building  
Wichita, Kansas

Barber County, Sec. 29 Twp. 31 Rge. 15 (E) W (W)  
Location as "NE/CNW $\frac{1}{4}$ SW $\frac{1}{4}$ " or footage from lines NE $\frac{1}{4}$ , NE $\frac{1}{4}$ , SE $\frac{1}{4}$   
Lease Owner Prime Drilling Company, et al  
Lease Name Dickerson # 1 Well No. 1  
Office Address 1516 Apco Tower, Oklahoma City, Oklahoma  
Character of Well (completed as Oil, Gas or Dry Hole) Dry Hole  
Date well completed 11-21-19 51  
Application for plugging filed 11-21-19 51  
Application for plugging approved 11-21-19 51  
Plugging commenced 11-21-19 51  
Plugging completed 11-21-19 51  
Reason for abandonment of well or producing formation  
If a producing well is abandoned, date of last production 19  
Was permission obtained from the Conservation Division or its agents before plugging was commenced? Yes

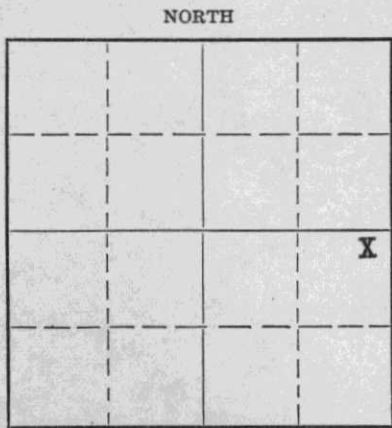

Locate well correctly on above Section Plat

Name of Conservation Agent who supervised plugging of this well C. D. Stough, Box 207, Great Bend, Kansas  
Producing formation Depth to top Bottom Total Depth of Well 5240 Feet  
Show depth and thickness of all water, oil and gas formations.

OIL, GAS OR WATER RECORDS

CASING RECORD

Formation	Content	From	To	Size	Put In	Pulled Out
				8-5/8	295'	None

Describe in detail the manner in which the well was plugged, indicating where the mud fluid was placed and the method or methods used in introducing it into the hole. If cement or other plugs were used, state the character of same and depth placed, from feet to feet for each plug set.

Filled hole with heavy drilling mud to 285' set Halliburton plug, cemented with 15 sacks of cement. Filled hole to 25' with heavy drilling mud, set Halliburton plug and cemented to bottom cellar with 10 sacks cement.

(If additional description is necessary, use BACK of this sheet)

Name of Plugging Contractor Prime Drilling Company  
Address 1516 Apco Tower, Oklahoma City, Oklahoma

STATE OF Oklahoma, COUNTY OF Oklahoma, ss.  
L. J. Kruse (employee of owner) or (owner) of the above-described well,

being first duly sworn on oath, says: That I have knowledge of the facts, statements, and matters herein contained and the log of the above-described well as filed and that the same are true and correct. So help me God.

(Signature) L. J. Kruse  
Oklahoma City, Oklahoma  
(Address)

SUBSCRIBED AND SWORN TO before me this 4th day of December, 1951

William Wright  
Notary Public.

My commission expires October 24, 1955

23-8390-s 6-51-20M  
PLUGGING  
FILE SEC-29 T 31 R 42  
BOOK PAGE 126 LINE 31

DEC-6 1951  
CONSERVATION DIVISION  
Wichita, Kansas

PRIME DRILLING COMPANY, C.S.PAGE, JR., ET AL

DICKERSON # 1

NE/4 NE/4 SE/4 Sec. 29-31-15W  
Barber County, Kansas

<u>FORMATION</u>	<u>FROM</u>	<u>TO</u>	<u>REMARKS</u>
Clay & Shale	0	130	
Sand	130	180	
Shale	180	200	
Shale & Sand	200	275	8-5/8" C.S.A. @ 295'. Cemented with 200 sacks cement.
Red Bed & Shells	275	1190	
Shale	1190	1266	
Shale Shells	1266	2065	
Shale & Lime	2065	2140	
Lime	2140	2270	
Lime & Shale	2270	2390	
Lime	2390	2610	
Lime & Shale Broken	2610	2680	
Lime & Shale	2680	2945	
Broken Lime	2945	3030	
Lime & Shale	3030	3195	
Shale	3195	3290	
Lime	3290	3380	
Shale	3380	3403	
Lime	3403	3448	
Shale & Lime	3448	3475	
Lime & Shale	3475	3575	
Lime	3575	3675	
Lime & Shale	3675	3750	
Lime	3750	3810	
Lime & Shale	3810	3920	
Lime	3920	3985	
Lime & Shale	3985	4142	
Lime	4142	4145	
Lime & Shale	4145	4350	
Lime	4350	4361	
Lime & Shale	4361	5200	
Lime	5200	5220	
Lime & Shale	5220	5240	
Total Depth		5240'	

I hereby certify the foregoing to be a true and accurate Driller's Log of the formations encountered in the above well.

PRIME DRILLING COMPANY

29 31 15W  
186 31 By:

L. J. Kruse  
L. J. Kruse, Secretary

Subscribed and swore to before me this 30th day of November, 1951.

Lillian Wright  
Notary Public

My Commission Expires: October 24, 1955

12-6-51