

STATE OF KANSAS  
STATE CORPORATION COMMISSION

WELL PLUGGING RECORD


OR

FORMATION PLUGGING RECORD

Strike out upper line when reporting plugging of formations.

Give All Information Completely  
Make Required Affidavit  
Mail or Deliver Report to:  
Conservation Division  
State Corporation Commission  
800 Bitting Building  
Wichita, Kansas

NORTH

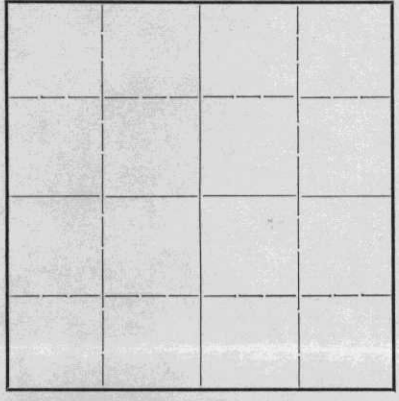

Locate well correctly on above Section Plat

Barber County, Sec. 12 Twp. 30S Rge. 15 (E) 15 (W)

Location as "NE 1/4 NW 1/4 SW 1/4" or footage from lines  
Lease Owner Luther Markell  
Lease Name Shoed Well No. 1  
Office Address White Hall  
Character of Well (completed as Oil, Gas or Dry Hole) Dry  
Date well completed 2-22 19 42  
Application for plugging filed 2-22 19 42  
Application for plugging approved 2-22 19 42  
Plugging commenced 2-22 19 42  
Plugging completed 2-22 19 42  
Reason for abandonment of well or producing formation Dry

If a producing well is abandoned, date of last production \_\_\_\_\_ 19 \_\_\_\_  
Was permission obtained from the Conservation Division or its agents before plugging was commenced? yes

Name of Conservation Agent who supervised plugging of this well C. J. Alexandria  
Producing formation \_\_\_\_\_ Depth to top \_\_\_\_\_ Bottom \_\_\_\_\_ Total Depth of Well 4661 Feet  
Show depth and thickness of all water, oil and gas formations.

OIL, GAS OR WATER RECORDS

CASING RECORD


Formation	Content	From	To	Size	Put In	Pulled Out
				<u>1 1/2" O.D.</u>	<u>P3/A</u>	

Describe in detail the manner in which the well was plugged, indicating where the mud fluid was placed and the method or methods used in introducing it into the hole. If cement or other plugs were used, state the character of same and depth placed, from \_\_\_\_\_ feet to \_\_\_\_\_ feet for each plug set.

HOLE FILLED WITH HEAVY MUD TO P3/A HOLE BRIDGED Cement  
WITH 15 sack cement. HOLE FILLED TO 10 FT OF CEMENT HOLE BRIDGED  
WITH 15 sack cement.

PK  
2/25/42  
Comm.  
St. Corp.  
By

PLUGGING  
FILE NO. 12-30-15W  
BOOK PAGE 35 LINE 43

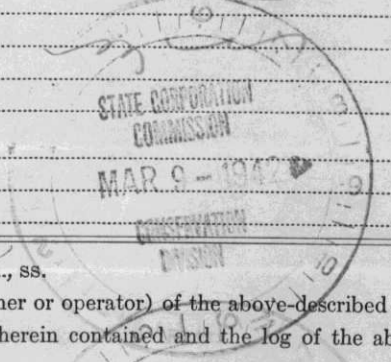

(If additional description is necessary, use BACK of this sheet)

Correspondence regarding this well should be addressed to \_\_\_\_\_  
Address \_\_\_\_\_

STATE OF Kansas, COUNTY OF Sedgwick, ss.  
L. J. Davis (Wilmerich & Payne) (employee of owner) or (owner or operator) of the above-described well,  
being first duly sworn on oath, says: That I have knowledge of the facts, statements, and matters herein contained and the log of the above-described well as filed and that the same are true and correct. So help me God.

(Signature) L. J. Davis  
402 Union Natl Bank Bldg. Wichita, Kas  
(Address)

SUBSCRIBED AND SWORN to before me this 7th day of March, 19 42  
Scott Shucky  
Notary Public.

My commission expires Feb 2 - 1944



Hoss #1  
N $\frac{1}{2}$  NW $\frac{1}{4}$  NW $\frac{1}{4}$  of Section 12-30S-15W,  
Barber County, Kansas  
Luther Mackall

Commenced: January 20, 1942.  
 Completed: February 23, 1942.

Sand and clay	0	22:	Lime	4285	4314
Sand	22	40	Lime and shale	4314	4405
River sand and surface clay	40	80	Chert	4405	4425
Red bed, shale and shells	80	370	Cherty conglomerate	4425	4448
Red bed, sand and shells	370	850	Lime	4448	4456
Red bed and shells	850	1100	Conglomerate	4456	4482
Lime and shale	1100	1258	Lime	4482	4506
Lime	1258	1275	Lime and shale	4506	4530
Lime and shale	1275	1360	Shale and sand	4530	4570
Salt, shale and shells	1360	1610	Shale	4570	4593
Lime and shale	1610	1880	Shale	4593	4605
Lime	1880	2000	Chert	4605	4615
Broken lime	2000	2055	Cherty Arbuckle	4615	4628
Lime	2055	2115	Cherty lime	4628	4643
Broken lime	2115	2172	Arbuckle lime	4643	4661
Lime	2172	2265			
Broken lime	2265	2285	TOTAL DEPTH	4661	
Sand streaks of lime	2285	2320			
Lime (cherty)	2320	2355			
Lime	2355	2465			
Shale	2465	2530			
Shale and lime	2530	2650			
Shale	2650	2661			
Shale and shells	2661	2724			
Shale and lime	2724	2855			
Broken lime	2855	2917			
Lime and shale	2917	3060			
Shale	3060	3090			
Shale and lime	3090	3125			
Lime	3125	3686			
Shale and lime	3686	3780			
Lime	3780	3784			
Sandy lime	3784	3820			
Lime and shale	3820	3847			
Lime	3847	3857			
Shale	3857	3894			
Lime	3894	3910			
Lime and shale	3910	3933			
Lime	3933	3990			
Lime (cherty)	3990	4012			
Lime	4012	4042			
Cherty lime	4042	4059			
Lime	4059	4116			
Shale and lime	4116	4150			
Lime	4150	4209			
Lime cherty	4209	4225			
Lime	4225	4262			
Lime and shale	4262	4285			

CASING RECORD

16" Casing set at 69' and cemented with 75 sacks of cement. Cement with 30 sacks in cellar.

PLUGGING RECORD

Filled hole with heavy mud to bottom of surface pipe and placed 15 sacks of cement. Filled with heavy mud to 35' and ran 15 sacks cement plug to 5' from bottom of cellar.

**PLUGGING**  
 FILE NO. 12.30.15W  
 BOOK PAGE 25 LINE 43



STATE OF OKLAHOMA)  
 )  
 COUNTY OF TULSA )

I hereby affirm that the above and foregoing is a true and correct copy of the log of your Hoss Well #1, located in the North Half of the Northwest Quarter of the Northwest Quarter of Section 12, Township 30 South, Range 15 West, Barber County, Kansas.

HUBBARD & PAYNE, INC.

BY William Boyd  
 Treasurer

Subscribed and sworn to before me, a Notary Public, this 12th day of March, 1942.

Lucie Griffin  
 Notary Public

My commission expires July 22nd, 1943.