


WELL PLUGGING RECORD

Give All Information Completely  
Make Required Affidavit  
Mail or Deliver Report to:  
Conservation Division  
State Corporation Commission  
800 Bittling Building  
Wichita, Kansas

NORTH

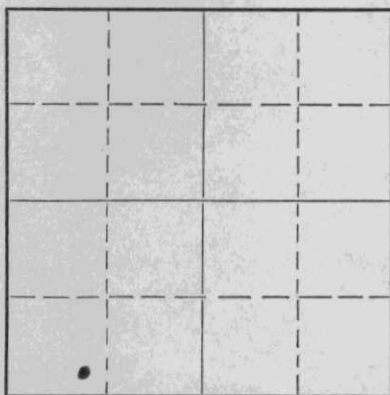

Locate well correctly on above  
Section Plat

Barber County. Sec. 5 Twp. 30 Rge. (E) 15 (W)  
Location as "NE/CNW<sup>1</sup>/<sub>4</sub>/SW<sup>1</sup>/<sub>4</sub>" or footage from lines SW SW SE  
Lease Owner Sinclair Oil & Gas Co  
Lease Name Louise Well No. 1  
Office Address Box 521, Tulsa, Okla  
Character of Well (completed as Oil, Gas or Dry Hole) Dry hole  
Date well completed April 3 1951  
Application for plugging filed April 4 1951  
Application for plugging approved April 4 1951  
Plugging commenced April 4 1951  
Plugging completed April 4 1951  
Reason for abandonment of well or producing formation dry hole completion

If a producing well is abandoned, date of last production - 19  
Was permission obtained from the Conservation Division or its agents before plugging was commenced? yes verbal permission  
Name of Conservation Agent who supervised plugging of this well C.D. Stough

Producing formation Depth to top Bottom Total Depth of Well 4923 Feet  
Show depth and thickness of all water, oil and gas formations.

OIL, GAS OR WATER RECORDS

CASING RECORD

Formation	Content	From	To	Size	Put In	Pulled Out
Lansing	dry	top 4083				
Arbuckle	dry	" 4903	4923 TD	10-3/4"	309'	0

Describe in detail the manner in which the well was plugged, indicating where the mud fluid was placed and the method or methods used in introducing it into the hole. If cement or other plugs were used, state the character of same and depth placed, from feet to feet for each plug set.

4923- 313' heavy mud  
313 -260 cement 25 sx  
260 - 0 heavy mud  
0 - btm cellar 25 sx cement

STATE CORPORATION COMMISSION  
APR 18 1951  
CONSERVATION DIVISION  
WICHITA, KANSAS

(If additional description is necessary, use BACK of this sheet)

Correspondence regarding this well should be addressed to Mr E.H. Gibbons  
Address Box 551, Chase, Kas

STATE OF Kansas, COUNTY OF Rice, ss.  
I, E.H. Gibbons (employee of owner) or (owner or operator) of the above-described well,  
being first duly sworn on oath, says: That I have knowledge of the facts, statements, and matters herein contained and the log of the above-described well as filed and that the same are true and correct. So help me God.

(Signature) *E.H. Gibbons*

Box 551 Chase, Kas  
(Address)

SUBSCRIBED AND SWORN to before me this 17th day of April, 1951

My commission expires Aug 22 - 1953

*B.J. Ritterhouse*  
Notary Public.

PLUGGING  
FILE SEC 5 T 30 R 154  
BOOK PAGE 71 LINE 16

Well Log  
Sinclair Oil & Gas Company

A.F.E. # 157  
Louise # 1  
SE/4, Sec. 5-303-15W Barber Co., Kas  
330' fm Sth & West lines  
Location made 3/6/1951, Barber Co. Engr/  
Ground Level Elev. 1976'  
Rig Floor 1980'

Harbar Drilling Co., rotary  
Spudded 7:00AM 3/14/51  
10-3/4" OD csg set @ 306' surface lev.  
meas. w/300 sx.

Geological Tops  
Lansing 4083' GL  
Arbuckle 4903 TD 4923' dryhole

Drillers Log  
Surface Level Measurements

Surface Soils, Sand, Clay	313'
Red Bed	643
Shale-Shells-Red Bed	983
Shale-Shells	993
10-3/4" csg set @ 306' w/300 sx	
Drlg 9" hole	
Shale-Shells-Red Bed	1163
Shale-Shells	2088
Shale-Lime	2138
Lime-Shale	2693
Shale-Lime	2743
Lime-Shale	2883
Shale-Lime	3118
Lime-Shale	3308
Shale-Lime	3413
Lime-Shale	3603
Lime	3688
Lime-Shale	3763
Lime-Shale-Sand	3873
Lime	3963
Lime-Shale-Sand	4098
Lime-Shale	4173
Lime	4253
Lime-Shale	4293
Lime	4328
Lime-Shale	4418
Lime	4453
Lime-Shale	4618
Conglomerate	4643
Lime-Shale	4713
Lime-Chert	4783
Lime-Shale-Chert	4838
Shale-Lime-Sand	4903
Lime	4923

Schlumberger Tops  
Kans City 4073  
Conglomerate 4611  
Viola 4651  
Simpson 4781  
Arbuckle 4884  
TD 4921

4/3/51 Ran Schlumberger @ 4923'  
All zones dry, no shows.

Good porosity in Arbuckle, no shows  
No pipe was run.

**RECEIVED**  
STATE CORPORATION COMMISSION  
APR - 6 1951  
CONSERVATION DIVISION  
Wichita, Kansas

<b>PLUGGING</b>
FILE SEC <u>6 T 30 R 152</u>
BOOK PAGE <u>71</u> LINE <u>16</u>