


STATE OF KANSAS
STATE CORPORATION COMMISSION

WELL PLUGGING RECORD

Give All Information Completely
Make Required Affidavit
Mail or Deliver Report to
Conservation Division
State Corporation Comm.
245 North Water
Wichita, KS 67202

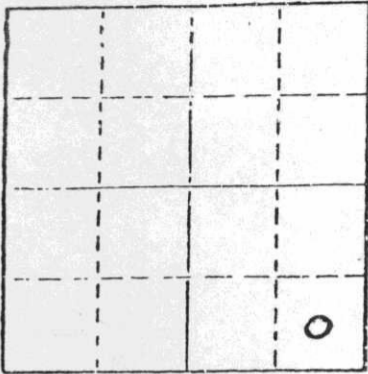

Locate well correctly on above
Section Plat

Barber County, Sec. 7 Twp. 30 Rge. 15 XX/W
Location as "NE/CNW 1/4 SW 1/4" or footage from lines _____

SE SE SE
Lease Owner SABINE PRODUCTION COMPANY

Lease Name Lee Well No. 1-7

Office Address 6400 NW Grand Blvd Suite 500 OK City OK 73116

Character of Well (Completed as Oil, Gas or Dry Hole) _____
Dry Hole

Date Well completed May 15 1983

Application for plugging file # Verbal Agreement 19

Application for plugging approved _____ 19

Plugging commenced May 15 1983

Plugging completed May 15 1983

Reason for abandonment of well or producing formation _____
Dry Hole

If a producing well is abandoned, date of last production _____ 19

Was permission obtained from the Conservation Division or its agents before plugging was commenced? Yes

Name of Conservation Agent who supervised plugging of this well Paul Luthi

Producing formation _____ Depth to top _____ Bottom _____ Total Depth of Well 4900'

Show depth and thickness of all water, oil and gas formations.

OIL, GAS OR WATER RECORDS

CASING RECORD

FORMATION	CONTENT	FROM	TO	SIZE	PUT IN	PULLED OUT
				8-5/8	1140'	None

Describe in detail the manner in which the well was plugged, indicating where the mud fluid was placed and the method or methods used in introducing it into the hold. If cement or other plugs were used, state the character of same and depth placed, from _____ feet to _____ feet for each plug set. Hole loaded to surface with drilling mud and cement plugs set as follows:

1190'	- 50 sx	60/40 Posmix, 2% gel, 3% CC
680'	- 40 sx	" " " " " "
40' to surface	- 10 sx	" " " " " " and plug
rathole	- 15 sx	" " " " " "

(If additional description is necessary, use BACK of this sheet)

Name of Plugging Contractor Dowell Div., Dowell Chemical Co.

STATE OF Oklahoma COUNTY OF Oklahoma, ss.
Vince J. Grass (employee of owner) or (owner or operator)

of the above-described well, being first duly sworn on oath, says: That I have knowledge of the facts, statements, and matters herein contained and the log of the above-described well as filed and that the same are true and correct. So help me God.

(Signature) Vince J. Grass
6401 N. W. Grand Blvd Suite 500 OK City, OK
(Address) 73116

SUBSCRIBED AND SWORN TO before me this 8 day of June, 1983

Neva Stepp
Notary Public.

My commission expires 2-23-86

RECEIVED
STATE CORPORATION COMMISSION

JUN 10 1983

CONSERVATION DIVISION
Wichita, Kansas