


WELL PLUGGING RECORD

Give All Information Completely  
Make Required Affidavit  
Mail or Deliver Report to:  
Conservation Division  
State Corporation Commission  
212 North Market, Insurance Bldg.  
Wichita, Kansas

Harper County, Sec. 16 Twp. 32S Rge. (E) 8 (W)

Location as "NE/CNW/SW" or footage from lines NW/4 NW/4 NW/4  
Lease Owner D. E. Dunne, Jr.  
Lease Name Hoyt Well No. 1  
Office Address 1005 Central Building, Wichita, Kansas  
Character of Well (completed as Oil, Gas or Dry Hole) Dry Hole  
Date well completed 8-19 19 60  
Application for plugging filed 8-23 19 60  
Application for plugging approved 8-25 19 60  
Plugging commenced 9- 7 19 60  
Plugging completed 9-10 19 60  
Reason for abandonment of well or producing formation Dry

NORTH

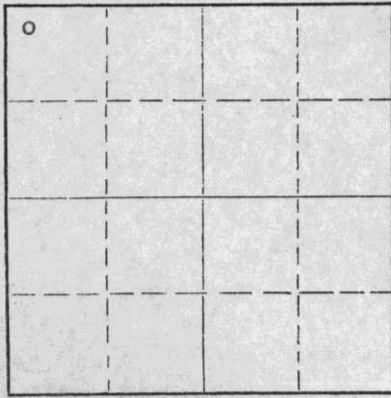

Locate well correctly on above Section Plat

If a producing well is abandoned, date of last production 19  
Was permission obtained from the Conservation Division or its agents before plugging was commenced? Yes

Name of Conservation Agent who supervised plugging of this well Fred Hampel, Pretty Prairie, Kansas  
Producing formation \_\_\_\_\_ Depth to top \_\_\_\_\_ Bottom \_\_\_\_\_ Total Depth of Well 4378 Feet  
Show depth and thickness of all water, oil and gas formations.

OIL, GAS OR WATER RECORDS

CASING RECORD

FORMATION	CONTENT	FROM	TO	SIZE	PUT IN	PULLED OUT
				8 5/8"	207'	-
				5 1/2"	4461'	3411.84'

Describe in detail the manner in which the well was plugged, indicating where the mud fluid was placed and the method or methods used in introducing it into the hole. If cement or other plugs were used, state the character of same and depth placed, from \_\_\_\_\_ feet to \_\_\_\_\_ feet for each plug set.

Filled with sand from 4378 to 4335'  
Filled with rock from 4335' to 4325'  
Dumped 4 sacks regular cement from 4325 to 4293'  
Set rock bridge 205' to 195'  
Dumped 20 sacks regular cement 195' to 130'  
Filled with mud from 130' to 35'  
Dumped 10 sacks of regular cement 35' to top.

RECORDED  
STATE CORPORATION COMMISSION  
SEP 14 1960  
CONSERVATION DIVISION  
Wichita, Kansas

(If additional description is necessary, use BACK of this sheet)

Name of Plugging Contractor D. E. Dunne, Jr.  
Address 1005 Central Building, Wichita, Kansas

STATE OF Kansas, COUNTY OF Sedgwick, ss.  
Almeda Day (employee of owner) or (owner or operator) of the above-described well, being first duly sworn on oath, says: That I have knowledge of the facts, statements, and matters herein contained and the log of the above-described well as filed and that the same are true and correct. So help me God.

(Signature) Almeda Day  
1005 Central Building, Wichita, Kansas  
(Address)

SUBSCRIBED AND SWORN TO before me this 12 day of September, 19 60

My commission expires 9-29-60

Notary Public.




WELL LOG BUREAU—KANSAS GEOLOGICAL SOCIETY  
508 East Murdock, Wichita, Kansas

Company- AURORA GASOLINE CO.  
Farm- Hoyt No. 1

SEC. 16 T. 32 R. 8W  
NW NW NW

Total Depth. 4773'  
Comm. 12-13-57 Comp. 1-4-58  
Shot or Treated.  
Contractor. Hilton Drlg.  
Issued. 7-5-58

County Harper  
KANSAS

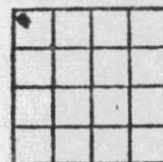

CASING:  
8 5/8" 209' cem w/175 sx.

Elevation. 1447' DF

Production. 21 BOPD

Figures Indicate Bottom of Formations.

red bed & shells	391
red bed, shells & shale	630
shale & shells	1240
shale & lime	1465
lime	1875
lime & shale	3165
lime	3235
lime, sand & shale	3340
lime & shale	3525
shale, lime & shells	3580
sand & shale	3655
lime, sand & shale	3735
lime	4124
lime & shale	4169
lime	4375
Mississippi	4395
chert & lime	4577
lime & shale	4655
shale, lime & chert	4713
lime & chert	4736
lime & shale	4748
sand & shale	4752
sand	4761
sand & shale	4773
Total Depth	

TOPS: SCOUT	
Heebner	3304
Douglas	3354
Kansas City	3872
Base Kansas City	4070
Marmaton	4088
Mississippi	4358
Viola	4686
Simpson	4743
Simpson Sand	4750