


STATE OF KANSAS
STATE CORPORATION COMMISSION

Give All Information Completely
Make Required Affidavit
Mail or Deliver Report to:
Conservation Division
State Corporation Commission
800 Bitting Building
Wichita, Kansas

WELL PLUGGING RECORD

NORTH

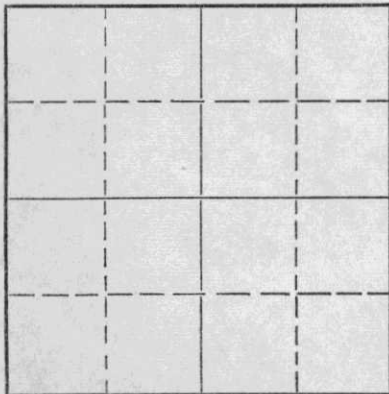

Locate well correctly on above
Section Plat

Barber County, Sec. 2 Twp. 32 Rge. (E) 12 (W)
Location as "NE/CNW%SW%" or footage from lines SE SW SW
Lease Owner Musgrove Petroleum Corporation
Lease Name SUSIE SMITH Well No. 1
Office Address 518 Petroleum Building, Wichita, Kans.
Character of Well (completed as Oil, Gas or Dry Hole) Dry hole
Date well completed November 16, 1954 19 54
Application for plugging filed February 4, 19 55
Application for plugging approved February 6, 19 55
Plugging commenced February 20, 19 55
Plugging completed February 20, 19 55
Reason for abandonment of well or producing formation Dry

If a producing well is abandoned, date of last production 19
Was permission obtained from the Conservation Division or its agents before plugging was commenced? Yes

Name of Conservation Agent who supervised plugging of this well
Producing formation Depth to top Bottom Total Depth of Well 4238' Feet
Show depth and thickness of all water, oil and gas formations.

OIL, GAS OR WATER RECORDS

CASING RECORD

FORMATION	CONTENT	FROM	TO	SIZE	PUT IN	PULLED OUT
				5-1/2"	4238'	3202'
				8-5/8"	257'	

Describe in detail the manner in which the well was plugged, indicating where the mud fluid was placed and the method or methods used in introducing it into the hole. If cement or other plugs were used, state the character of same and depth placed, from feet to feet for each plug set.

Set Lane Wells plug at 4175'. Put 2 sx
cement on top as per State's request. Filled
hole with heavy mud. Well was flowing water.
Pumped in 20 sacks mud and 75 sacks cement.
Filled surface casing to surface.

(If additional description is necessary, use BACK of this sheet)

Name of Plugging Contractor Arnett Casing Pulling Company
Address Hoisington, Kansas.

STATE OF Kansas, COUNTY OF Sedgwick
I, Gordon L. Koelling, (employee of owner) or (owner or operator) of the above-described well, being first duly sworn on oath, says: That I have knowledge of the facts, statements, and matters herein contained and the log of the above-described well as filed and that the same are true and correct. So help me God.

(Signature)

518 Petroleum Building, Wichita, Kansas.

(Address)

SUBSCRIBED AND SWORN to before me this 24th day of February, 19 55

My commission expires September 24, 1956.

24-7368-S 3-53-20M



RECEIVED
STATE CORPORATION COMMISSION

FEB 26 1955 11-26-55
CONSERVATION DIVISION
Wichita, Kansas

PLUGGING
FILE SEC 2 T 32 R 12W
BOOK PAGE 95 LINE 30

CONTRACTOR'S WELL LOG

COMPANY: Musgrove Petroleum Corporation
CONTRACTOR: Musgrove Petroleum Corporation
FARM: SUSIE SMITH #1
LOCATION: SE SW SW, Sec. 2-32-12W
Barber County, Kansas.
COMMENCED: November 3, 1954
COMPLETED: November 16, 1954

0	115	Sand - red bed
115	270	Red bed
270	645	Red bed & anhydrite
645	799	Red bed & shale
799	1470	Shale & shells
1470	1497	Lime
1497	1665	Lime & shells
1665	1860	Shale
1860	1950	Lime & shale
1950	2030	Lime
2030	3368	Lime & shale
3368	3435	Sand & lime
3435	3525	Lime & shale
3525	3623	Lime
3623	3644	Douglas sand
3644	4215	Lime
4215	4224	Lime & chert
4224	4238	Mississippi
	4238	Rotary Total Depth

Set 8-5/8" surface pipe at 257' with 150 sacks cement, 2% calcium chloride.

Set 5-1/2" casing at 4238' with 100 sacks cement.

STATE OF KANSAS }
COUNTY OF SEDGWICK } SS

I, Gordon L. Koelling, do hereby certify that the above and foregoing is a true and correct copy of the log of the SUSIE SMITH #1, SE SW SW, Sec. 2-32-12, Barber County, Kansas, as reflected by the files of the Musgrove Petroleum Corporation.

MUSGROVE PETROLEUM CORPORATION

By *Gordon L. Koelling*
Secretary-Treasurer

Subscribed and sworn to before me, a Notary Public, in and for Sedgwick County, Kansas, this 19th day of November, 1954.

Thelma L. Stinson
Notary Public

My commission expires September 24, 1956.

PLUGGING
FILE SEC 2 T32 R12W
BOOK PAGE 95 LINE 30

RECEIVED
STATE CORPORATION COMMISSION
FEB - 3 1955
CONSERVATION DIVISION
Wichita, Kansas

11-5-55