

STATE OF KANSAS
STATE CORPORATION COMMISSION

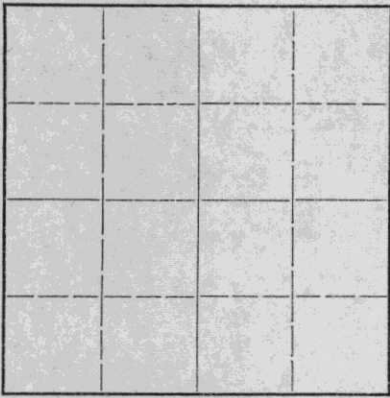
WELL PLUGGING RECORD

OR

FORMATION PLUGGING RECORD

Strike out upper line
when reporting plug-
ging off formations.Give All Information Completely
Make Required Affidavit
Mail or Deliver Report to:
Conservation Division
State Corporation Commission
800 Bittling Building
Wichita, Kansas

NORTH

Locate well correctly on above
Section Plat

BARBER

County. Sec. 2 Twp. 32 Rge. 12 (E) W (W)

Location as "NE1/4NW1/4SW1/4" or footage from lines. SW, NW, NW,

Lease Owner. Beardmore Drilling - C. S. Page, - John Wells

Lease Name. Benefiel Well No. 1

Office Address. 603 Petroleum Bldg., Wichita, Kansas

Character of Well (completed as Oil, Gas or Dry Hole). Dry hole

Date well completed. August 4, 1950

Application for plugging filed. August 4, 1950

Application for plugging approved. August 4, 1950

Plugging commenced. August 4, 1950

Plugging completed. August 4, 1950

Reason for abandonment of well or producing formation. Dry hole

If a producing well is abandoned, date of last production. 19

Was permission obtained from the Conservation Division or its agents before plugging was com-
menced? Yes

Name of Conservation Agent who supervised plugging of this well. C. D. Stough

Producing formation. none Depth to top. Bottom. Total Depth of Well. 4771 Feet

Show depth and thickness of all water, oil and gas formations.

OIL, GAS OR WATER RECORDS

CASING RECORD

Formation	Content	From	To	Size	Put In	Pulled Out
				8-5/8"	160 ft	none

Describe in detail the manner in which the well was plugged, indicating where the mud fluid was placed and the method or methods used in
introducing it into the hold. If cement or other plugs were used, state the character of same and depth placed, from top feet to
bottom feet for each plug set.Mud to 160 feet, set plug and ~~then~~ dumped 15 sacks of cement;
Mud to 40 feet, set plug and 10 sacks of cement; then mud
to complete; cap surface

(If additional description is necessary, use BACK of this sheet)

Correspondence regarding this well should be addressed to. Beardmore Drilling Company
Address. 603 Petroleum Bldg., Wichita 2, Kansas

STATE OF Kansas, COUNTY OF Sedgwick, ss.

Heber Beardmore (employee of owner) or (owner or operator) of the above-described well,
being first duly sworn on oath, says: That I have knowledge of the facts, statements, and matters herein contained and the log of the above-
described well as filed and that the same are true and correct. So help me God.

(Signature)

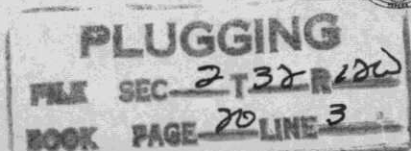
603 Petroleum Bldg., Wichita, Kansas
(Address)

SUBSCRIBED AND SWORN to before me this 15th day of August, 1950.

My commission expires. October 11, 1952.

21-6858-RS

2-47-6M

RECEIVED Ebbel Murray
Conservation Div. Notary Public.

AUG 16 1950

8-16-50

STATE CORPORATION
COMMISSION
KANSAS

Benefiel No. 1 Well

SW, NW, NW,
Section 2-32-12W,
Barber County, Kansas.

Drilled for: Page, Beardmore, et al
Drilled by: Beardmore Drilling Company

Casing Record:

8-5/8" 160' w/100 sacks

Drilling Commenced: July 13, 1950.
Drilling Completed: August 4, 1950.

Elevation: 1517 (DF)

<u>FORMATION</u>	<u>DEPTH</u>
Red rock	160
Shale - shells	1000
Shale 0 line	1415
Shale - Lime	1605
Lime	1935
Lime - shale	2385
Shale - lime	2480
Lime - Shale	2540
Shale	2645
Shale - shells	2985
Lime	3080
Lime - broken	3155
Lime	3220
Lime - shale	3290
Lime - shale	3345
Shale	3371
Sand	3382
Sand - shale	3445
Shale	3515
Lime	3615
Shale - lime	3659
22% Sand	3680
Sand	3690
Lime	3865
Broken lime	3890
Lime	4285
Shale - lime	4306
Lime	4410
Lime - shale	4555
Lime	4620
Lime - sand	4630
Core	4648
Shale	4718
Arbuckle lime	4730
Lime	4771. T. D.
D & A	
Tops:	
Elgin Sand	3371
Douglas	3657
Lansing-KC	3680
Mississippi	4285
Viola	4532
Simpson	4619
Arbuckle	4718

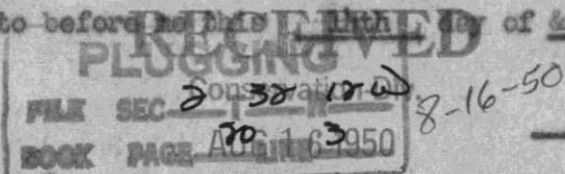
STATE OF KANSAS

SS
COUNTY OF SEDGWICK

I, the undersigned, being duly sworn on oath state that the above and within statement is a true and correct record and log of the well drilled on the location above-described to the best of my knowledge and belief.

Edsel Murray

Subscribed and sworn to before me this 4th day of August, 1950.



Edsel Murray
Notary Public

My Commission Expires

October 11, 1952.

STATE CORPORATION
COMMISSION
KANSAS