


SEP 24 1980

STATE OF KANSAS
STATE CORPORATION COMMISSION

WELL PLUGGING RECORD

Give All Information Completely
Make Required Affidavit
Mail or Deliver Report to
Conservation Division
State Corporation Comm.
245 North Water
Wichita, KS 67202

Barber County, Sec. 10 Twp. 30S Rge. 15W /E/W
Location as "NE/CNW/SW" or footage from lines
50' S of W/2 NE/4 SW/4
Lease Owner Gear Petroleum Company
Lease Name Brickey "A" Well No. 1
Office Address 300 Sutton Place, Wichita, Ks. 67202
Character of Well (Completed as Oil, Gas or Dry Hole)

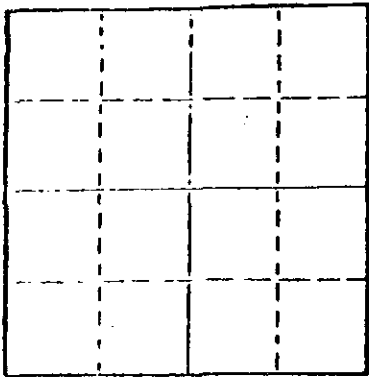

Locate well correctly on above
Section Plot

D & A
Date Well completed September 13, 1980
Application for plugging filed September 13, 1980
Application for plugging approved September 13, 1980
Plugging commenced September 13, 1980
Plugging completed September 13, 1980
Reason for abandonment of well or producing formation

D & A
If a producing well is abandoned, date of last production 19

Was permission obtained from the Conservation Division or its agents before plugging was commenced? Yes

Name of Conservation Agent who supervised plugging of this well Wm. T. Owen
Producing formation Depth to top Bottom Total Depth of Well 4,730'
Show depth and thickness of all water, oil and gas formations.


OIL, GAS OR WATER RECORDS

CASING RECORD

FORMATION	CONTENT	FROM	TO	SIZE	PUT IN	PULLED OUT
				8 5/8"	1,034'	-0-

Describe in detail the manner in which the well was plugged, indicating where the mud fluid was placed and the method or methods used in introducing it into the hold. If cement or other plugs were used, state the character of same and depth placed, from feet to feet for each plug set.

Plugged hole @ 850' w/50 sx cement
@ 720' w/40 sx cement
Bridge @ 40' w/10 sx cement
10 sx cement in rathole

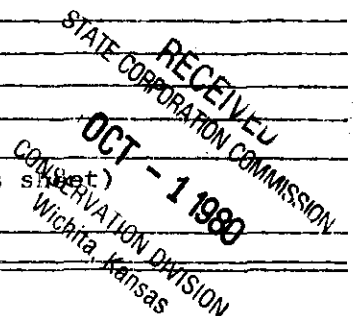

(If additional description is necessary, use BACK of this sheet)
Name of Plugging Contractor Red Tiger Drilling Company
1720 KSB&T Building, Wichita, Kansas 67202


STATE OF Kansas COUNTY OF Sedgwick, ss. contractor
Gloria Fawcett (employee of ~~Red Tiger Drilling Company~~)
of the above-described well, being first duly sworn on oath, says: That I have knowledge of the facts, statements, and matters herein contained and the log of the above-described well as filed and that the same are true and correct. So help me God.

(Signature) Gloria Fawcett
1720 KSB&T Building, Wichita, Kansas 67202
(Address)

SUBSCRIBED AND SWORN TO before me this 22nd day of September, 1980.

Joyce A. Hagermann
Notary Public.

My commission expires

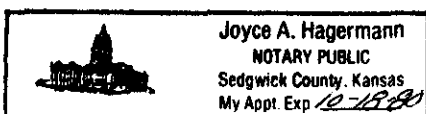

SEP 24 1980

DRILLERS LOG

No. 1 Brickey "A"

CASING RECORD:	COMPANY:	Gear Petroleum Company, Inc.	DESCRIPTION:
8 5/8" @ 1,041' w/450 sx cement	CONTRACTOR:	Red Tiger Drilling Company	50' S of W/2 NE/4 SW/4 Sec. 10-T30S-R15W Barber County, Kansas
D & A	COMMENCED:	August 30, 1980	
TOTAL DEPTH: 4,730'	COMPLETED:	September 13, 1980	ELEVATION: 1,979' GL

<u>FORMATION</u>	<u>FROM</u>	<u>TO</u>	<u>REMARKS</u>
Sand & Red Bed	0	275	
Sand & Clay	275	700	
Red Bed	700	1043	
Shale	1043	1360	
Lime & Shale	1360	4570	
Lime	4570	4600	
Lime & Shale	4600	4664	
Lime	4664	4730	
RTD		4730	

I certify that this is a true and correct copy of the above log to the best of my knowledge.

RED TIGER DRILLING COMPANY

Gloria Fawcett
Gloria Fawcett

Subscribed and sworn to before me this 22nd day of September, 1980.

Joyce A. Hagermann
Notary Public

