

WELL PLUGGING RECORD

Give All Information Completely
Make Required Affidavit
Mail or Deliver Report to:
Conservation Division
State Corporation Commission
211 No. Broadway
Wichita, Kansas

Barber

County. Sec. 10 Twp. 30S Rge. (E) 15 (W)

Location as "NE/CNW&SW¼" or footage from lines SW¼ SE¼ SW¼

Lease Owner Monsanto Chemical Company, Lion Oil Company Division

Lease Name Hullie Well No. 1

Office Address P. O. Box 580, Pratt, Kansas

Character of Well (completed as Oil, Gas or Dry Hole) Dry Hole

Date well completed May 13, 19 57

Application for plugging filed May 13, 19 57


Application for plugging approved (Verbal) May 13, 19 57

Plugging commenced May 13, 19 57

Plugging completed 4:15pm May 13, 19 57

Reason for abandonment of well or producing formation Dry hole

NORTH

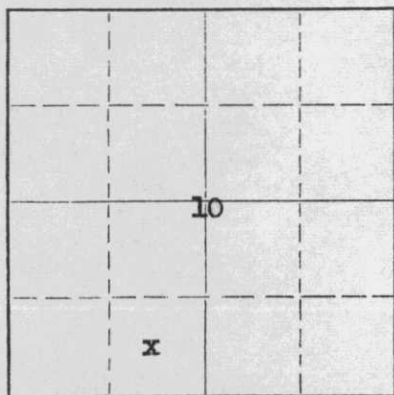

Locate well correctly on above Section Plat

If a producing well is abandoned, date of last production 19

Was permission obtained from the Conservation Division or its agents before plugging was commenced? Yes

Name of Conservation Agent who supervised plugging of this well Mr. Merle Rives

Producing formation Depth to top Bottom Total Depth of Well 4822 Feet

Show depth and thickness of all water, oil and gas formations.

OIL, GAS OR WATER RECORDS

CASING RECORD

FORMATION	CONTENT	FROM	TO	SIZE	PUT IN	PULLED OUT
				8-5/8"	259'	None

Describe in detail the manner in which the well was plugged, indicating where the mud fluid was placed and the method or methods used in introducing it into the hole. If cement or other plugs were used, state the character of same and depth placed, from feet to feet for each plug set.

Filled hole with heavy mud from 4822' to 250'. Set Halliburton plug at 250' with 1/3 sack of hulls and 20 sacks of cement. Filled hole with heavy mud to 35'. Set Halliburton plug at 35' with 1/3 sack of hulls and 10 sacks of cement to top of 8-5/8" casing.

RECEIVED
STATE CORPORATION COMMISSION
MAY 16 1957
CONSERVATION DIVISION
Wichita, Kansas

(If additional description is necessary, use BACK of this sheet)

Name of Plugging Contractor Garvey Drilling Company

Address 352 North Broadway, Wichita, Kansas

STATE OF KANSAS, COUNTY OF PRATT, ss.
Bruce E. Roll (employee of owner) or (owner or operator) of the above-described

well, being first duly sworn on oath, says: That I have knowledge of the facts, statements, and matters herein contained and the log of the above-described well as filed and that the same are true and correct. So help me God.

(Signature) Bruce E. Roll

P. O. Box 580, Pratt, Kansas
(Address)

SUBSCRIBED AND SWORN TO before me this 14th day of May, 19 57

Mike F. Loubert

Notary Public.

My commission expires September 19, 1959

PLUGGING
FILE SEC 10 T 30 R 15W
BOOK PAGE 13 LINE 9

WELL LOG

COMPANY THE LION OIL COMPANY
FARM HULLIE NO. 1


SEC. 10 T. 30S R. 15W
LOC. SE, SE, SW

TOTAL DEPTH 4822'

COUNTY Barber Co., Kansas

COMM. April 24, 1957 COMP. May 13, 1957

CONTRACTOR GARVEY DRILLING COMPANY

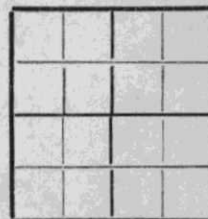

CASING 8 5/8" @ 258.60' W/200 sax.

ELEVATION 1948' DF

PRODUCTION D & A

FIGURES INDICATE BOTTOM OF FORMATIONS

600	Sand, red bed & shale
800	Red bed & shale
905	Shale
1490	Red bed & shale
1815	Shale & shells
2000	Lime & shale
2482	Lime
3575	Lime & shale
3816	Lime
3876	Lime & shale
3957	Shale & sand
4025	Lime & shale
4572	Lime
4591	Lime & chert
4633	Lime
4665	Lime & chert
4695	Lime
4700	Lime & shale
4752	Sand (Simp)
4822	Lime
4822	T. D.

PLUGGING
 FILE SEC. 10 T. 30 R. 15W
 BOOK PAGE 13 LINE 9

RECEIVED
STATE CORPORATION COMMISSION

MAY 25 1957

CONSERVATION DIVISION
Wichita, Kansas

State of KANSAS }
County of BARTON } ss:

I, Verne A. Morris of Garvey Drilling Co.

upon oath state that the above and foregoing is a true and correct copy of the log of the #1 Hullie well

Verne A. Morris

Subscribed and sworn to before me this 21st day of May 19 57

My Commission Expires: November 12, 1958

Grandenburg
NOTARY PUBLIC