


Give All Information Completely
Make Required Affidavit
Mail or Deliver Report to:
Conservation Division
State Corporation Commission
211 No. Broadway
Wichita, Kansas

WELL PLUGGING RECORD

NORTH

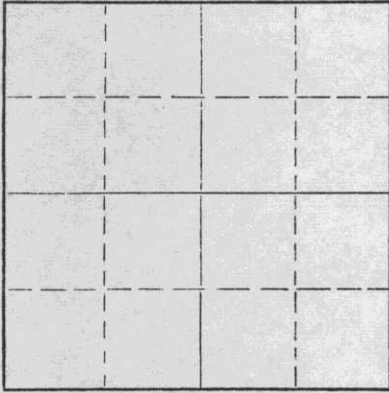

Locate well correctly on above
Section Plat

Harper County, Sec. 15 Twp. 32 Rge. (E) 8 (W)
Location as "NE/CNW&SW" or footage from lines SE SE NW
Lease Owner Rupp-Ferguson Oil Co.
Lease Name Bebermeyer Well No. 1
Office Address 522 Union Center, Wichita, Kansas
Character of Well (completed as Oil, Gas or Dry Hole) Dry Hole
Date well completed 9-22-57 19
Application for plugging filed 9-22-57 19
Application for plugging approved 9-22-57 19
Plugging commenced 9-22-57 19
Plugging completed 9-22-57 19
Reason for abandonment of well or producing formation

If a producing well is abandoned, date of last production 19
Was permission obtained from the Conservation Division or its agents before plugging was commenced? Yes

Name of Conservation Agent who supervised plugging of this well M. A. Rives
Producing formation Depth to top Bottom Total Depth of Well 5060 Feet
Show depth and thickness of all water, oil and gas formations.

OIL, GAS OR WATER RECORDS

CASING RECORD

FORMATION	CONTENT	FROM	TO	SIZE	PUT IN	PULLED OUT
				8 5/8	230	0

Describe in detail the manner in which the well was plugged, indicating where the mud fluid was placed and the method or methods used in introducing it into the hole. If cement or other plugs were used, state the character of same and depth placed, from feet to feet for each plug set.

Circ. heavy mud in hole, lay down drill pipe, filled hole w/mud to 225'
1/2 sack hulls, plug to 225, 20 sax cement thru d.p. Filled hole to 35',
1/2 sack hulls, plug, cement to base of cellar.

(If additional description is necessary, use BACK of this sheet)
Name of Plugging Contractor Rupp-Ferguson Oil Co.
Address 522 Union Center, Wichita

STATE OF Kansas, COUNTY OF Sedgwick, ss.
L. W. Knox (employee of owner) or (owner or operator) of the above-described well, being first duly sworn on oath, says: That I have knowledge of the facts, statements, and matters herein contained and the log of the above-described well as filed and that the same are true and correct. So help me God.

(Signature) [Signature]
522 Union Center, Wichita, Kansas
(Address)

SUBSCRIBED AND SWORN TO before me this 26th day of September, 19 57

My commission expires June 4, 1959

[Signature] Helen Horine
Notary Public.

RECEIVED
STATE CORPORATION COMMISSION
9-27-57
PLUGGING
FILE SEC 15 T 32 R 8W
BOOK PAGE 47 LINE 41

CONTRACTOR'S WELL LOG

Rupp-Ferguson No. 1 Bebermeyer
SE SE NW, Sec. 15-32-8W,
Harper County, Kansas

Elevation 1423 KB
D & A

Commenced: 9-4-57
Completed: 9-22-57
Contractor: Rupp-Ferguson Oil Co.

Set 230' of 8 5/8" surface csg. w/150 sax

Figures Indicate Bottom of Formation

- 21 sand
- 130 red bed
- 350 shale, shells, red bed
- 1030 shale & shells
- 1310 salt, shells, shale, lime streaks
- 1500 lime & shale streaks
- 1670 lime & shale
- 1760 lime & shale streaks
- 1775 sand & lime
- 1907 lime & shale
- 2145 shale
- 2499 lime & shale
- 2683 shale & lime streaks
- 3640 lime & shale
- 3745 sandy lime & shale
- 3916 lime & shale
- 3969 lime
- 4051 lime & chert
- 4197 lime
- 4305 lime & shale
- 4350 lime
- 4411 lime & shale
- 4417 lime
- 4704 Miss.
- 4789 Kinderhook
- 4842 Viola
- 4977 Simpson
- 5008 sand
- 5060 Arb. T.D.

STATE OF KANSAS)
SEDGWICK COUNTY) SS:

I, L. W. Knox, Landman for Rupp-Ferguson Oil Co., do hereby certify that the above and foregoing is a true and correct copy of the log of the No. 1 Bebermeyer well.

RECEIVED
STATE CORPORATION COMMISSION
SEP 27 1957
CONSERVATION DIVISION
WICHITA, KANSAS

L. W. Knox
L. W. Knox

Subscribed and sworn to before me this 26th day of September, 1957.

Helen Horine
Notary Public

My Commission Expires June 4, 1959.

PLUGGIN
FILE SEC. 15 T32 8W
BOOK PAGE 47 LI 41