


Give All Information Completely
Make Required Affidavit
Mail or Deliver Report to:
Conservation Division
State Corporation Commission
212 No. Market
Wichita, Kansas

WELL PLUGGING RECORD

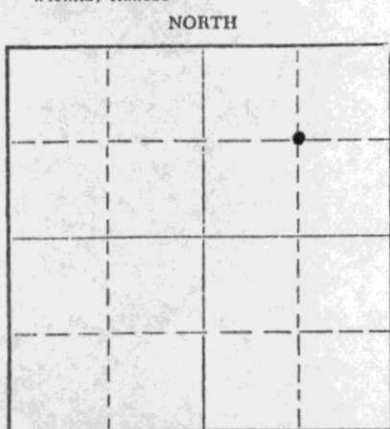

Locate well correctly on above
Section Plat

Harper County, Sec. 17 Twp. 32S Rge. 8 (E) 8 (W)
Location as "NE/CNW/SW" or footage from lines 1320' FN&EL
Lease Owner Anadarko Production Company
Lease Name Robinson "A" Well No. 1
Office Address Box 351 Liberal, Kansas 67901
Character of Well (completed as Oil, Gas or Dry Hole) Dry Hole
Date well completed 3/26 19 73
Application for plugging filed 3/28 19 73
Application for plugging approved Verbal Approval Before Plugging
Plugging commenced 3/26 19 73
Plugging completed 3/26 19 73
Reason for abandonment of well or producing formation Rotary D & A

If a producing well is abandoned, date of last production 19
Was permission obtained from the Conservation Division or its agents before plugging was commenced? Yes

Name of Conservation Agent who supervised plugging of this well G. R. Biberstein Attica, Kansas 67009
Producing formation _____ Depth to top _____ Bottom _____ Total Depth of Well 4770 Feet
Show depth and thickness of all water, oil and gas formations.

OIL, GAS OR WATER RECORDS

CASING RECORD

FORMATION	CONTENT	FROM	TO	SIZE	PUT IN	PULLED OUT
				8 5/8	209	NONE

Describe in detail the manner in which the well was plugged, indicating where the mud fluid was placed and the method or methods used in introducing it into the hole. If cement or other plugs were used, state the character of same and depth placed, from _____ feet to _____ feet for each plug set.

Spotted 40 sx. cement 250' to 150'.

Spotted 10 sx. cement 40' to surface.

RECEIVED
STATE CORPORATION COMMISSION
APR 4 1973
CONSERVATION DIVISION
Wichita, Kansas

(If additional description is necessary, use BACK of this sheet)
Name of Plugging Contractor Sweetman Drilling Inc.
Address Wichita, Kansas 67202

STATE OF KANSAS, COUNTY OF SEWARD, ss.
T. W. WILLIAMS (employee of owner) or (owner or operator) of the above-described well, being first duly sworn on oath, says: That I have knowledge of the facts, statements, and matters herein contained and the log of the above-described well as filed and that the same are true and correct. So help me God.

(Signature) T. W. WILLIAMS DIVISION OFFICE SUPERVISOR
BOX 351 LIBERAL, KANSAS 67901
(Address)

NORMA JEAN TUCKER
NOTARY PUBLIC
Seward County, Kansas
SUBSCRIBED AND SWORN to before me this 2nd day of APRIL, 1973
September 9, 1976

Notary Public.

My commission expires _____

DRILLER'S LOG

WELL NAME Robinson "A" #1 COMPANY OPERATING Anadarko Production Company
 ADDRESS OF COMPANY Box 351 Liberal, Kansas 67901

WELL LOCATION $\frac{1}{4}$ $\frac{1}{4}$ $\frac{1}{4}$
3960 Ft. North of South Line,
3960 Ft. East of West Line, Sec. 17, Twp. 32S, Rge. 8W, Harper County, Kansas

DRILLING STARTED 3/14, 19 73, DRILLING COMPLETED 3/26, 19 73
 WELL COMPLETED 3/26, 19 73, WELL CONNECTED _____, 19 _____

ELEVATION 1457.0 Ft. Ground Level CHARACTER of WELL (Oil, Gas, Dry Hole) Dry Hole

OIL OR GAS SANDS OR ZONES - PERFORATIONS - ACIDIZING AND FRACTURING INFORMATION					
Name	From	To	No. of Shots	Gallons Used	Kind Used

RECEIVED
 STATE CORPORATION COMMISSION
 APR 4 1973
 CONSERVATION DIVISION
 Wichita, Kansas

CASING RECORD

Size	Amount Set	Sacks of Cement	Amount Pulled
8 5/8	209	300	NONE

FORMATION RECORD

Formation	Top	Bottom	Formation	Top	Bottom
Red Bed & Shale	0	99	Shale	4538	4710
Red Bed	99	218	Lime	4710	4770
Shale	218	1270	TOTAL DEPTH	4770	
Shale & Lime	1270	1380			
Lime & Shale	1380	3077			
Shale & Lime	3077	3270			
Lime & Shale	3270	3545			
Shale & Lime	3545	3622			
Sand	3622	3738			
Shale & Lime	3738	3805			
Lime	3885	4377			
Lime & Chert	4377	4538			

RESULTS OF INITIAL PRODUCTION TEST: D & A