

Give All Information Completely
Make Required Affidavit
Mail or Deliver Report to:
Conservation Division
State Corporation Commission
211 No. Broadway
Wichita, Kansas

WELL PLUGGING RECORD

Harper County, Sec. 9 Twp. 32S Rge. 8 (X) (W)

Location as "NE/CNW/SW" or footage from lines C SW SW

Lease Owner Stelbar Oil Corporation, Inc.

Lease Name Hoyt Well No. 1

Office Address 310 Petroleum Bldg., Wichita 2, Kansas

Character of Well (completed as Oil, Gas or Dry Hole) Oil

Date well completed March 12, 19 62

Application for plugging filed March 20, 19 63

Application for plugging approved March 22, 19 63

Plugging commenced March 29, 19 63


Plugging completed April 1, 19 63

Reason for abandonment of well or producing formation

Well was dry

If a producing well is abandoned, date of last production None 19

Was permission obtained from the Conservation Division or its agents before plugging was commenced? Yes

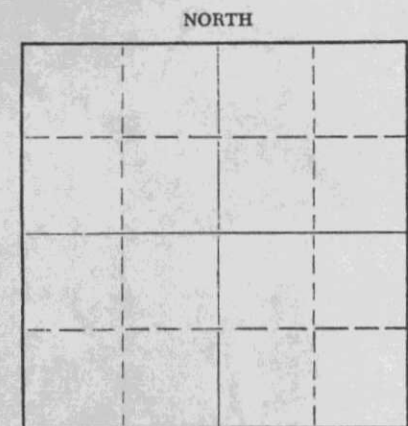

Locate well correctly on above Section Plat

Name of Conservation Agent who supervised plugging of this well Archie Elving

Producing formation Depth to top Bottom Total Depth of Well Feet

Show depth and thickness of all water, oil and gas formations.

OIL, GAS OR WATER RECORDS

CASING RECORD

FORMATION	CONTENT	FROM	TO	SIZE	PUT IN	PULLED OUT
				8-5/8"	211'	None
				5-1/2"	4369'	3619.63

Describe in detail the manner in which the well was plugged, indicating where the mud fluid was placed and the method or methods used in introducing it into the hole. If cement or other plugs were used, state the character of same and depth placed, from feet to feet for each plug set.

Run 5 sacks of cement from 4369 to 4340. Shot at 3913, 3703, 3605 and started 5-1/2" pipe. Mudded from 4340 to 210, rock bridge 210 to 200. Run 20 sacks of cement from 200 to 140. Mudded from 140 to 35. Rock and 10 sacks of cement from 35 to base of cellar.

RECEIVED
STATE CORPORATION COMMISSION

APR 16 1963

CONSERVATION DIVISION
Wichita, Kansas

Name of Plugging Contractor Glenn & Smith Pipe Pulling Co., Box 114, Ellinwood, Kansas
Address

STATE OF KANSAS COUNTY OF SEDGWICK, ss.
Bertrand M. Lester, Jr. (employee of owner) or (XXXXXX) of the above-described well, being first duly sworn on oath, says: That I have knowledge of the facts, statements, and matters herein contained and the log of the above-described well as filed and that the same are true and correct. So help me God.

(Signature) Bertrand M. Lester, Jr.
310 Petroleum Bldg., Wichita 2, Kansas
(Address)

SUBSCRIBED AND SWORN TO before me this 15th day of April, 19 63

My commission expires May 7, 1966. Talia Zuhars Notary Public.



DRILLER'S LOG

Company:
Contractor:
Farm:
Location:

Jones-Gebert Oil, Inc.
Jones-Gebert Oil, Inc.
Hoyt #1
C SW SW, Sec. 9-32S-9W
Harper County, Kansas
2/28/62
3/12/62
8-5/8" @211' w/175 sz.
5-1/2" @4369' w/100 sz. poemix.

Commenced:
Completed:
Casings:

0	-	30	Surface clay sand
30	-	120	Shale and lime
120	-	211	Shale and lime
211	-	636	Shale w/lime streaks
636	-	1280	Shale and shells
1280	-	1400	Shale w/lime streaks
1400	-	1615	Lime w/shale streaks
1615	-	1800	Lime w/shale streaks
1800	-	1900	Lime and shale
1900	-	2037	Lime and shale
2037	-	2310	Shale w/lime streaks
2310	-	2320	Lime and shale
2320	-	2520	Shale and lime
2520	-	2635	Lime and shale
2635	-	2785	Lime and shale
2785	-	2925	Lime and shale
2925	-	3075	Shale and lime
3075	-	3185	Shale and lime
3185	-	3230	Shale and lime
3230	-	3450	Lime and shale
3450	-	3565	Lime and shale
3565	-	3600	Shale and lime
3600	-	3620	Stainaker sand
3620	-	3735	Sand
3735	-	3867	Lime and shale
3867	-	3925	K.C. lime
3925	-	3980	K.C. lime
3980	-	4033	K.C. lime
4033	-	4066	K.C. lime
4066	-	4083	Lime
4083	-	4127	Shale and lime
4127	-	4193	Lime and shale
4193	-	4234	Shale and lime
4234	-	4295	Lime and shale
4295	-	4342	Lime and shale
4342	-	4365	Mississippi
4365	-	4369	Mississippi
4369	-	4374	Mississippi
4374	-		Rotary Total Depth

RECEIVED
STATE CORPORATION COMMISSION

MAR 20 1963

CONSERVATION DIVISION
Wichita, Kansas

I, Albert J. Gebert III, do hereby certify that the above and foregoing is a true and correct copy of the log of the #1 Hoyt, C SW SW, Sec. 9-32S-9W, Harper County, Kansas, as reflected by the files of Jones-Gebert Oil, Inc.

Albert J. Gebert III

State of Kansas, County of Sedgwick)ss:

Subscribed and sworn to before me, a Notary Public, in and for Sedgwick County, Kansas, this _____ day of March, 1962.

Barbara J. Layton, Notary Public