


STATE OF KANSAS
STATE CORPORATION COMMISSION

WELL PLUGGING RECORD

Give All Information Completely
Make Required Affidavit
Mail or Deliver Report to
Conservation Division
State Corporation Comm.
245 North Water
Wichita, KS 67202

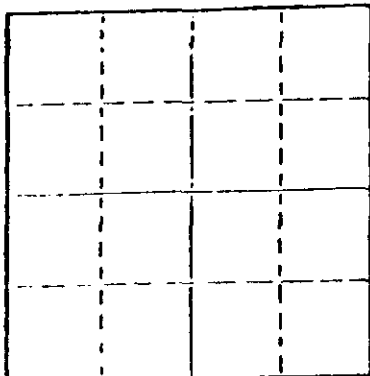

Locate well correctly on above
Section Map

Barber County. Sec. 9 Twp. 31S Rge. 13W E/W XXX
Location as "NE/CNW/SW" or footage from lines
660' FNL and 660' FEL

Lease Owner Texas Oil and Gas Corp.

Lease Name Maddix "A" Well No. 4 OWWD

Office Address 200 W. Douglas, Suite 300, Wichita, KS

Character of Well (Completed as Oil, Gas or Dry Hole)
Dry Hole

Date Well completed July 29, 19 77

Application for plugging filed Verbal Application 19 77

Application for plugging approved Verbal Approval 19 77

Plugging commenced July 29, 19 77

Plugging completed July 29, 19 77

Reason for abandonment of well or producing formation

If a producing well is abandoned, date of last production
19 77

Was permission obtained from the Conservation Division or
its agents before plugging was commenced? Yes

Name of Conservation Agent who supervised plugging of this well Buddy Metz

Producing formation _____ Depth to top _____ Bottom _____ Total Depth of Well 2905'

Show depth and thickness of all water, oil and gas formations.

OIL, GAS OR WATER RECORDS

CASING RECORD

FORMATION	CONTENT	FROM	TO	SIZE	PUT IN	PULLED OUT
				8 5/8"	309'	none

Describe in detail the manner in which the well was plugged, indicating where the mud fluid was placed and the method or methods used in introducing it into the hold. If cement or other plugs were used, state the character of same and depth placed, from _____ feet to _____ feet for each plug set.

Filled hole with heavy rotary mud from 2,906' to 260'. Set plug at 260' and cemented with 40 sacks cement. Filled hole with heavy rotary mud from 260' to 40'. Set solid plug at 40' and cemented to cellar with 12 sacks cement, 3 sacks cement in rat hole.

RECEIVED
STATE CORPORATION COMMISSION
AUG 1 1977
CONSERVATION DIVISION
Wichita, Kansas

(If additional description is necessary, use BACK of this sheet)
Name of Plugging Contractor Halliburton Services

STATE OF Kansas COUNTY OF Sedgwick, ss.

Dean Britting -- agent (employee of owner) or (owner or operator) of the above-described well, being first duly sworn on oath, says: That I have knowledge of the facts and statements, and matters herein contained and the log of the above-described well as filed and that the same are true and correct. So help me God.

(Signature)

Dean Britting
200 N. Main, Wichita, KS 67202
(Address)

SUBSCRIBED AND SWORN TO before me this 8th day of August, 19 77

Elsie Willison -- Notary Public.

My commission expires June 30, 1978

KANSAS GEOLOGICAL SOCIETY
KANSAS WELL LOG BUREAU—KANSAS WELL SAMPLE BUREAU
KANSAS GEOLOGICAL SOCIETY BUILDING
508 EAST MURDOCK - WICHITA, KANSAS

COMPANY Texas Oil & Gas Corp.

FARM Maddix "A"

NO. 40WWC

SEC. 9 T. 31S R. 13W
LOC. 660' FNL and
660' FEL

TOTAL DEPTH 2905'

COMM. July 27, 1977

SHOT OR TREATED


CONTRACTOR H-30, Inc.

ISSUED August 8, 1977

COMP. July 29, 1977

COUNTY Barber

KANSAS

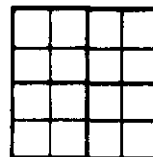

CASING

20

10

15

8

12

6

13

5

5/8" 309' cemented w/ 225 sxs cement

ELEVATION

1702 KB

PRODUCTION

FIGURES INDICATE BOTTOM OF FORMATIONS

Old Rotary Total Depth

2905'

Washed down to

//

Rotary Total Depth

2905'

RECEIVED
STATE CORPORATION COMMISSION

AUG 11 1977

CONSERVATION DIVISION
Wichita, Kansas

I hereby certify the above and foregoing to be
a true and correct log of the above described well
as shown by the drilling reports.

H-30, Inc.

Dean Britting
Dean Britting

State of Kansas

County of Sedgwick

ss:

Subscribed and Sworn to before me a Notary Public
in and for said county and state this 8th day of August,
1977.

Elsie Willison
Elsie Willison--Notary Public

My Commission Expires:

June 30, 1978