


WELL PLUGGING RECORD

Give All Information Completely
Make Required Affidavit
Mail or Deliver Report to:
Conservation Division
State Corporation Commission
800 Bitting Building
Wichita, Kansas

NORTH

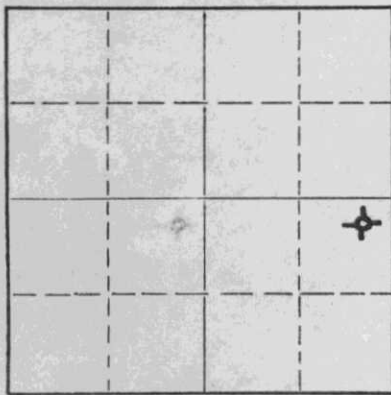

Locate well correctly on above
Section Plat

Barber County. Sec. 9 Twp. 31S Rge. 13W (E) (W)
Location as "NE/CNW/SW" or footage from lines. NE NE SE
Lease Owner AURORA GASOLINE COMPANY
Lease Name KEETNER Well No. 1
Office Address 802 Union National Bank Building
Character of Well (completed as Oil, Gas or Dry Hole) Dry Hole
Date well completed 6-6-55 19
Application for plugging filed 6-6-55 19
Application for plugging approved 6-6-55 19
Plugging commenced 6-6-55 19
Plugging completed 6-6-55 19
Reason for abandonment of well or producing formation dry hole

If a producing well is abandoned, date of last production none 19
Was permission obtained from the Conservation Division or its agents before plugging was commenced? Yes Yes

Name of Conservation Agent who supervised plugging of this well Merle Rives
Producing formation _____ Depth to top _____ Bottom _____ Total Depth of Well 4710 Feet 4710
Show depth and thickness of all water, oil and gas formations.

OIL, GAS OR WATER RECORDS

CASING RECORD

FORMATION	CONTENT	FROM	TO	SIZE	PUT IN	PULLED OUT
				8-5/8"	217'	None

Describe in detail the manner in which the well was plugged, indicating where the mud fluid was placed and the method or methods used in introducing it into the hole. If cement or other plugs were used, state the character of same and depth placed, from _____ feet to _____ feet for each plug set.

Bottom plug at 210' with 20 sx of cement with 1/2 sx of hulls.
Top plug at 40' with 10sx of cement & 1 1/2 Gal. of hulls.
Top plug tied with Halliburton line.

(If additional description is necessary, use BACK of this sheet)

Name of Plugging Contractor S. A. Berwick
Address Great Bend, Kansas

STATE OF Kansas, COUNTY OF Sedgwick, ss.
Leonard Olds (employee of owner) or (owner or operator) of the above-described well, being first duly sworn on oath, says: That I have knowledge of the facts, statements, and matters herein contained and the log of the above-described well as filed and that the same are true and correct. So help me God.

(Signature) Leonard Olds
Leonard Olds
Pratt, Kansas (Roberts Hotel)
(Address)

SUBSCRIBED AND SWORN TO before me this 6th day of July, 1955

Frances C. Newlon
Frances C. Newlon Notary Public.

My commission expires October 23, 1957

PLUGGING
FILE SEC 9 T 31 R 13W
BOOK PAGE 125 LINE 36

RECEIVED
STATE CORPORATION COMMISSION
7-8-55
JUL 8 - 1955
CONSERVATION DIVISION

AURORA GASOLINE COMPANY

Ketner
 Total Depth: 4710'
 Commenced R.D.: 5-17-55
 Completed R.D.: 6-5-55

NE NE SE Sec. 9 31S-13W
 Barber County, Kansas
 Elevation: 1667 DF
 Initial Prod.:
 Contractor: S.A. Berwick
 Drilling Company

Strata	Depth
Red Rock and Shale	0 - 150
Shale	150 - 220
Shale and Shells	220 - 1130
Lime and Shale	1130 - 1835
Lime	1835 - 1920
Lime and Shale	1920 - 2575
Sand	2575 - 3791
Lime	3791 - 3810
Lime and Shale	3810 - 3855
Lime	3855 - 3895
Churt and Lime	3895 - 4294
Lime	4294 - 4350
Lime and Shale	4350 - 4410
Lime	4410 - 4490
Lime and Shale	4490 - 4630
Sand	4630 - 4670
Lime	4670 - 4710

I hereby certify the above a true and correct log of said well as reflected by the daily drilling report.

S.A. BERWICK DRILLING COMPANY

By S.A. Berwick

Signed and sworn to in my presence this 7 day of June, 1955, by S.A. Berwick Owner of the S.A. Berwick Drilling Company.

John W. Poo
 Notary Public

My Commission Expires: 4-11-59

PLUGGING
 FILE SEC 9 T 31 R 13W
 BOOK PAGE 125 LINE 31

RECEIVED
 OIL CORPORATION COMMISSION

7-8-55