


WELL PLUGGING RECORD

Give All Information Completely
Make Required Affidavit
Mail or Deliver Report to:
Conservation Division
State Corporation Commission
211 No. Broadway
Wichita, Kansas

NORTH

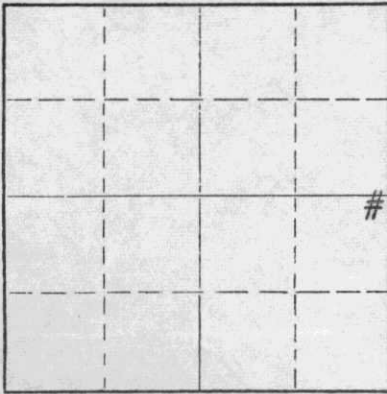

Locate well correctly on above
Section Plat

Barber County. Sec. 9 Twp. 31 Rge. 13 (E) W (W)
Location as "NE/CNW&SW&" or footage from lines NE/NE/SE
Lease Owner Petroleum Management Inc.
Lease Name Ketner Well No. 1
Office Address 1515 Wichita Plaza Wichita, Ks.
Character of Well (completed as Oil, Gas or Dry Hole) Oil
Date well completed _____ 19____
Application for plugging filed _____ 19____
Application for plugging approved _____ 19____
Plugging commenced Mar. 31, 1965
Plugging completed Apr. 2, 1965
Reason for abandonment of well or producing formation No longer a producer.

If a producing well is abandoned, date of last production _____ 19____
Was permission obtained from the Conservation Division or its agents before plugging was commenced? Yes

Name of Conservation Agent who supervised plugging of this well Archie Elving
Producing formation _____ Depth to top _____ Bottom _____ Total Depth of Well 4710 Feet
Show depth and thickness of all water, oil and gas formations.

OIL, GAS OR WATER RECORDS

CASING RECORD

FORMATION	CONTENT	FROM	TO	SIZE	PUT IN	PULLED OUT
				8 5/8	217'	None
				5 1/2	4553'	2101'

Describe in detail the manner in which the well was plugged, indicating where the mud fluid was placed and the method or methods used in introducing it into the hole. If cement or other plugs were used, state the character of same and depth placed, from _____ feet to _____ feet for each plug set.

Plugged back with sand from 4235' to 4210'. Mixed and dumped 5 sx. of cement from 4210' to 4170' with dump bailer. Pulled casing. Mudded hole to 220'. Set 10' rock bridge from 220' to 210'. Mixed and dumped 25 sx. of cement from 210' to 135'. Mudded hole from 135' to 40'. Set 10' rock bridge from 40' to 30'. Mixed and dumped 10 sx. of cement from 30' to base of the cellar.

RECEIVED
STATE CORPORATION COMMISSION
MAY 3 1965
CONSERVATION DIVISION
Wichita, Kansas

(If additional description is necessary, use BACK of this sheet)
Name of Plugging Contractor Ace Pipe Pulling Co.
Address Box 304 Great Bend, Ks.

STATE OF Kansas, COUNTY OF Sedgwick, ss.

(employee of owner) or (owner or operator) of the above-described well, being first duly sworn on oath, says: That I have knowledge of the facts, statements, and matters herein contained and the log of the above-described well as filed and that the same are true and correct. So help me God.

(Signature) J. R. Pritchard
(Address) _____

SUBSCRIBED AND SWORN TO before me this 30th day of April, 1965

My commission expires April 23, 1966
Marie C. Murphy
Marie C. Murphy Notary Public.

WELL LOG BUREAU - KANSAS GEOLOGICAL SOCIETY
508 East Murdock, Wichita, Kansas


COPY

Company- AURORA GASOLINE CO.
Farm- Ketner No. 1

SEC. 9 T. 31 R. 13W
NE NE SE

Total Depth. 4710
Comm. 5-17-55 Comp. 6-5-55
Shot or Treated.
Contractor. S. A. Berwick Drilling Co.
Issued. 7-23-55

County Barber
KANSAS

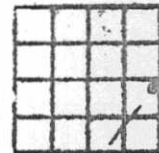

Elevation. 1667 DF

Production. Dry

CASING:

Figures Indicate Bottom of Formations

red rock & shale	150
shale	220
shale & shells	1130
lime & shale	1835
lime	1920
lime & shale	2575
sand	3791
lime	3810
lime & shale	3855
lime	3895
chert & lime	4294
lime	4350
lime & shale	4410
lime	4490
lime & shale	4630
sand	4670
lime	4710
Total Depth	

SCOUT TOPS:

Heebner	3602
L/Douglas	3757
Lansing	3789
Mississippi	4273
Viola	4453
Simpson shale	4520
Simpson sand	4567
Arbuckle	4657

RECEIVED
STATE CORPORATION COMMISSION
MAY 18 1965
CONSERVATION DIVISION
Wichita, Kansas