


Give All Information Completely
Make Required Affidavit
Mail or Deliver Report to:
Conservation Division
State Corporation Commission
211 No. Broadway
Wichita, Kansas

WELL PLUGGING RECORD

Barber County. Sec. 9 Twp. 31 Rge. 13 (E) W (W)
Location as "NE/CNWSWK" or footage from lines SW/NE/SW
Lease Owner Petroleum Management Inc.
Lease Name Ketner Well No. 2
Office Address 1515 Wichita Plaza Wichita, Ks.
Character of Well (completed as Oil, Gas or Dry Hole) _____
Date well completed _____ 19____
Application for plugging filed _____ 19____
Application for plugging approved _____ 19____
Plugging commenced _____ Dec. 4, 19 64
Plugging completed _____ Dec. 8, 19 64
Reason for abandonment of well or producing formation _____

NORTH

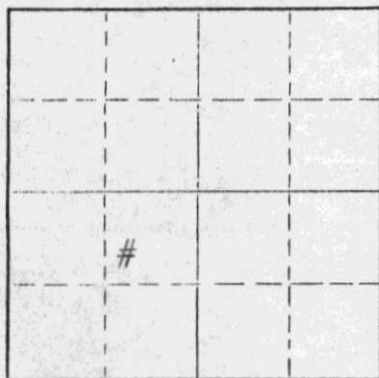

Locate well correctly on above
Section Plat

Name of Conservation Agent who supervised plugging of this well Archie Elving
Producing formation _____ Depth to top _____ Bottom _____ Total Depth of Well _____ Feet
Show depth and thickness of all water, oil and gas formations.

OIL, GAS OR WATER RECORDS

CASING RECORD

FORMATION	CONTENT	FROM	TO	SIZE	PUT IN	PULLED OUT
				8 5/8 4 1/2	242' 4590'	None 3623'

Describe in detail the manner in which the well was plugged, indicating where the mud fluid was placed and the method or methods used in introducing it into the hole. If cement or other plugs were used, state the character of same and depth placed, from _____ feet to _____ feet for each plug set.

Plugged back with sand from 4310' to 4000'. Mixed and dumped 4 sx. of cement with dump bailer from 4000' to 3952'. Pulled casing. Mudded hole to 240'. Set 10' rock bridge from 240' to 230'. Mixed and dumped 25 sx. of cement from 230' to 155'. Mudded hole from 155' to 40'. Set 10' rock bridge from 40' to 30'. Mixed and dumped 10 sx. of cement from 30' to base of the cellar.

RECEIVED
STATE CORPORATION COMMISSION

DEC 16 1964

CONSERVATION DIVISION
Wichita, Kansas

(If additional description is necessary, use BACK of this sheet)

Name of Plugging Contractor Ace Pipe Pulling Co.
Address Box 304 Great Bend, Ks.

STATE OF Kansas COUNTY OF Sedgwick, ss.
John W. Patchey (employee of owner) or (owner or operator) of the above-described well, being first duly sworn on oath, says: That I have knowledge of the facts, statements, and matters herein contained and the log of the above-described well as filed and that the same are true and correct. So help me God.
(Signature) _____

SUBSCRIBED AND SWORN to before me this 15th day of December, 19 64
Mare C. Murphy (Address) _____
Notary Public.

My commission expires April 23, 1966

