


STATE OF KANSAS  
STATE CORPORATION COMMISSION

WELL PLUGGING RECORD

Give All Information Completely  
Make Required Affidavit  
Mail or Deliver Report to  
Conservation Division  
State Corporation Comm.  
245 North Water  
Wichita, KS 67202

Barber County, Sec. 7 Twp. 32S Rge. 11 E/W  
Location as "NE/CNW $\frac{1}{4}$ SW $\frac{1}{4}$ " or footage from lines \_\_\_\_\_

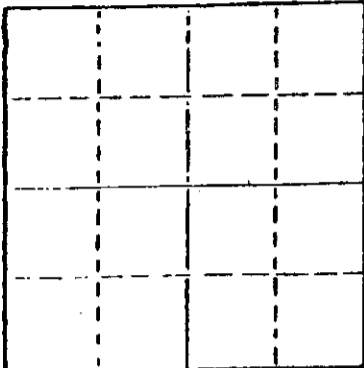

Locate well correctly on above  
Section Plot

SW NW SW  
Lease Owner Gear Petroleum Co., Inc.  
Lease Name Axtell Well No. 1  
Office Address 300 Sutton Place, Wichita, Kansas 67202  
Character of Well (Completed as Oil, Gas or Dry Hole) \_\_\_\_\_

Dry Hole  
Date Well completed August 14, 1980  
Application for plugging filed August 14, 1980  
Application for plugging approved August 14, 1980  
Plugging commenced August 14, 1980  
Plugging completed August 14, 1980  
Reason for abandonment of well or producing formation \_\_\_\_\_

If a producing well is abandoned, date of last production 19 \_\_\_\_\_

Was permission obtained from the Conservation Division or its agents before plugging was commenced? Yes

Name of Conservation Agent who supervised plugging of this well Wm. T. Owen, Pratt, Kansas  
Producing formation \_\_\_\_\_ Depth to top \_\_\_\_\_ Bottom \_\_\_\_\_ Total Depth of Well 4350'  
Show depth and thickness of all water, oil and gas formations.

OIL, GAS OR WATER RECORDS

CASING RECORD

FORMATION	CONTENT	FROM	TO	SIZE	PUT IN	PULLED OUT
				8-5/8"	248'	None

Describe in detail the manner in which the well was plugged, indicating where the mud fluid was placed and the method or methods used in introducing it into the hold. If cement or other plugs were used, state the character of same and depth placed, from \_\_\_\_\_ feet to \_\_\_\_\_ feet for each plug set.

Pumped 40 sacks cement through drill pipe to 240 feet. Pushed plug and hulls to 40 feet with 10 sacks. Plugged rat hole with 5 sacks cement.

STATE CORPORATION COMMISSION  
RECEIVED  
AUG 21 1980  
CONSERVATION DIVISION  
Wichita, Kansas

(If additional description is necessary, use BACK of this sheet)  
Name of Plugging Contractor Graves Drilling Co., Inc.

STATE OF KANSAS COUNTY OF SEDGWICK, ss.  
Betty Brandt (employee of owner) or (owner or operator)  
of the above-described well, being first duly sworn on oath, says: That I have knowledge of the facts, statements, and matters herein contained and the log of the above-described well as filed and that the same are true and correct. So help me God.

(Signature) Betty Brandt  
910 Union Center, Wichita, Kansas 67202  
(Address)

SUBSCRIBED AND SWORN TO before me this 20th day of August, 1980

Max W. Satterthwaite  
Max W. Satterthwaite Notary Public.

My commission expires May 17, 1983

ROTARY DRILLERS' LOG

OPERATOR: Gear Petroleum Co., Inc. DRILLING COMMENCED: August 6, 1980  
 300 Sutton Place  
 Wichita, Kansas 67202

CONTRACTOR: Graves Drilling Co., Inc. DRILLING COMPLETED: August 14, 1980  
 910 Union Center  
 Wichita, Kansas 67202

CASING RECORD: 6 Jts. 248' of new 8-5/8" LOCATION: Axtell No. 1  
 cemented with 225 sacks SW NW SW  
 Section 7-32S-11W  
 Barber County, Kansas

0 - 60 Sand  
 60 - 370 Red bed  
 370 - 1181 Red bed & shale  
 1181 - 1669 Shale  
 1669 - 4304 Shale & lime  
 4304 - 4350 Lime  
 4350 Rotary Total Depth

I hereby certify the foregoing statements to be true and correct to the best of my knowledge.

GRAVES DRILLING CO., INC.

By Betty Sarratt  
Secretary-Treasurer

Copy sent to:  
Corporation Commission  
Kansas Geological Society  
Kansas Geological Survey

RECEIVED  
STATE CORPORATION COMMISSION  
AUG 21 1980  
8-21-80  
CONSERVATION DIVISION  
Wichita, Kansas

STATE OF KANSAS )  
 ) ss.  
SEDGWICK COUNTY )

Subscribed and sworn to before me, a Notary Public, this 20th day of August, 1980.

Max W. Satterthwaite  
Max W. Satterthwaite Notary Public

My commission expires:

May 17, 1983