


STATE OF KANSAS  
STATE CORPORATION COMMISSION

Give All Information Completely  
Make Required Affidavit  
Mail or Deliver Report to:  
Conservation Division  
State Corporation Commission  
800 Bitting Building  
Wichita, Kansas

WELL PLUGGING RECORD

NORTH

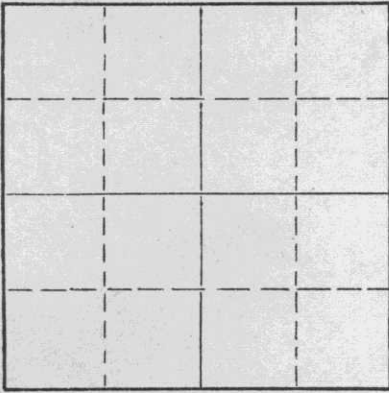

Locate well correctly on above  
Section Plat

Barber County, Sec. 14 Twp. 31S Rge. (E) 13 (W)  
Location as "NE/CNW/SW" or footage from lines SE SW SE  
Lease Owner William Graham Oil Company & John R. LeBosquet  
Lease Name Mathews Well No. 1  
Office Address 1005 East Second Street, Wichita, Kansas  
Character of Well (completed as Oil, Gas or Dry Hole) Dry Hole  
Date well completed October 6, 1954 19  
Application for plugging filed October 6, 1954 (Verbal) 19  
Application for plugging approved October 6, 1954 (Verbal) 19  
Plugging commenced October 6, 1954 19  
Plugging completed October 6, 1954 19  
Reason for abandonment of well or producing formation D & A

If a producing well is abandoned, date of last production 19  
Was permission obtained from the Conservation Division or its agents before plugging was commenced? Yes

Name of Conservation Agent who supervised plugging of this well M. A. Rives, Pratt, Kansas  
Producing formation \_\_\_\_\_ Depth to top \_\_\_\_\_ Bottom \_\_\_\_\_ Total Depth of Well 3604 Feet  
Show depth and thickness of all water, oil and gas formations.

OIL, GAS OR WATER RECORDS

CASING RECORD

FORMATION	CONTENT	FROM	TO	SIZE	PUT IN	PULLED OUT
				8 5/8"	180	None

Describe in detail the manner in which the well was plugged, indicating where the mud fluid was placed and the method or methods used in introducing it into the hole. If cement or other plugs were used, state the character of same and depth placed, from \_\_\_\_\_ feet to \_\_\_\_\_ feet for each plug set.

Plugged hole 25 sacks cement @ 300'  
Set bottom plug at 180' - spotted  
5 sacks cement. Filled up with mud  
to 35'. Filled pipe up to bottom  
of cellar with cement.

RECEIVED  
STATE CORPORATION COMMISSION

NOV - 5 1954 11-5-54

CONSERVATION DIVISION  
Wichita, Kansas

(If additional description is necessary, use BACK of this sheet)  
Name of Plugging Contractor William Graham Oil Company  
Address 1005 East Second Street, Wichita, Kansas

STATE OF Kansas, COUNTY OF Sedgwick, ss.  
William L. Graham (employee of owner) or (owner or operator) of the above-described well, being first duly sworn on oath, says: That I have knowledge of the facts, statements, and matters herein contained and the log of the above-described well as filed and that the same are true and correct. So help me God.

(Signature) *William L. Graham*  
1005 East Second Street, Wichita, Kansas  
(Address)

SUBSCRIBED AND SWORN TO before me this 11th day of October, 19 54

My commission expires June 23, 1958

*John Duncan*  
Notary Public.

PLUGGING  
FILE SEC 14 T 31 R 13W  
BOOK PAGE 69 LINE 33

No. 1 Mathews

WELL RECORD

Location: SE SW SE 14-31S-13W  
Barber County, Kansas

Commenced: September 25, 1954

Operator: William Graham Oil Co.  
1005 East Second Street  
Wichita, Kansas

Completed: October 6, 1954

Elevation: 1631 RB

Contractor: William Graham Oil Co.  
1005 East Second Street  
Wichita, Kansas

Production: D & A

Casing Record: 8 5/8" @ 180' w/108 sacks cement

LOG


Red bed	180
Red bed	270
Red bed & shale & shells	860
Shale & shells	1375
Lime	1430
Lime & shale	1770
Lime	1835
Sandy lime	1945
Lime & shale	2040
Shale & lime	2165
Lime	2248
Shale & shells	2325
Lime & streaks shale	2435
Lime & shale	2530
Shale	2780
Shale & lime	2850
Lime	3355
Shale & lime	3385
Sand	3398
Lime	3580
Shale & lime	3594
Sand	3604 R.T.D.

T O P S

Elgin sand	3385
Base Elgin sand	3398
Douglass sand	3594

The undersigned, William Graham Oil Company, hereby certifies that the above log is a true and correct log of the formations encountered in drilling the above well as reflected by the Daily Drilling Report.

WILLIAM GRAHAM OIL COMPANY

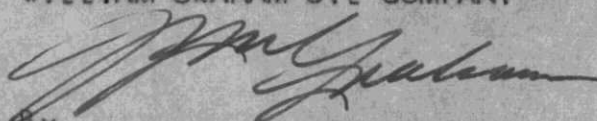

By \_\_\_\_\_  
William L. Graham

Subscribed and sworn to before me this 11th day of October, 1954.

W. H. Duncan  
Notary Public

10-30-54

My commission expires: June 23, 1958

**PLUGGING**  
 MKR SEC 14 31 13W  
 BOOK PAGE 69 LINE 33