

STATE OF KANSAS
STATE CORPORATION COMMISSION


WELL PLUGGING RECORD

Give All Information Completely
Make Required Affidavit
Mail or Deliver Report to:
Conservation Division
State Corporation Commission
800 Bitting Building
Wichita, Kansas

OR
FORMATION PLUGGING RECORD

Strike out upper line
when reporting plug-
ging off formations.

NORTH

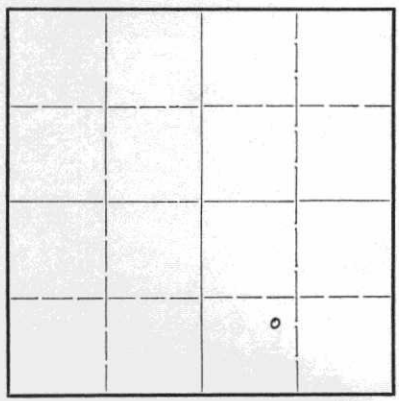

Locate well correctly on above
Section Plat

Barber County. Sec. 6 Twp. 31 Rge. 13 (W)
Location as "NE $\frac{1}{4}$ NW $\frac{1}{4}$ SW $\frac{1}{4}$ " or footage from lines NE $\frac{1}{4}$ SW $\frac{1}{4}$ SE $\frac{1}{4}$
Lease Owner The Drillers Gas Company
Lease Name J. L. Gant Well No. 1
Office Address 903 Union National Bldg., Wichita, Kansas
Character of Well (completed as Oil, Gas or Dry Hole) Dry hole
Date well completed July 2 1945
Application for plugging filed 19
Application for plugging approved 19
Plugging commenced July 31 1946
Plugging completed August 3 1946
Reason for abandonment of well or producing formation Non-productive
If a producing well is abandoned, date of last production None 19
Was permission obtained from the Conservation Division or its agents before plugging was com-
menced? Yes

Name of Conservation Agent who supervised plugging of this well H. W. Kerr
Producing formation Depth to top Bottom Total Depth of Well 4,793 Feet
Show depth and thickness of all water, oil and gas formations.


OIL, GAS OR WATER RECORDS

CASING RECORD

Formation	Content	From	To	Size	Put In	Pulled Out
Arbuckle		4,743	4,793	5 $\frac{1}{2}$ "	4,678'	3,015'
Simpson		4,651				
Maq. Viola	water & ss gas	4,532				
Kinderhook		4,471				
Mississippi		4,424				
Conglomerate		4,417				
Lansing K.G.	714	3,916				
Douglas		3,877				

Describe in detail the manner in which the well was plugged, indicating where the mud fluid was placed and the method or methods used in introducing it into the hole. If cement or other plugs were used, state the character of same and depth placed, from feet to feet for each plug set.

Cement 4,793' to 4,630'
 Crushed rock 4,630' to 4,625'
 Lane-Wells plug @ 4,125'
 Crushed rock 4,125' to 3,850'
 5 sks. cement @ 3,850'
 Mud 3,850 to 400'
 15 sks. cement @ 400'
 Mud 370' to 20'
 10 sks. cement 20' to surface

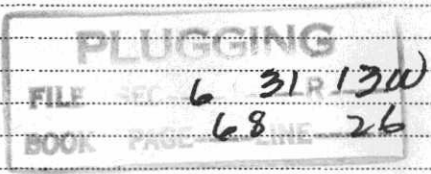

(If additional description is necessary, use BACK of this sheet)

Correspondence regarding this well should be addressed to The Drillers Gas Company, 903 Union National Bldg.
Address Wichita 2, Kansas

STATE OF KANSAS, COUNTY OF SEDGWICK, ss.
L. B. Stewart (employee of owner) or (owner or operator) of the above-described well,

being first duly sworn on oath, says: That I have knowledge of the facts, statements, and matters herein contained and the log of the above-described well as filed and that the same are true and correct. So help me God.

(Signature) [Signature]
903 Union National Bldg., Wichita 2, Kansas
(Address)

SUBSCRIBED AND SWORN to before me this 26th day of September, 1946

My commission expires August 13, 1947

[Signature] Notary Public.

The Drillers Gas Co.,
Gant Well #1

SE/4, Sec 6, T31S, R13W,
Barber County, Kansas.

NE-SW-SE

Total Depth 4795
Comm. 4/11/45
Comp. 5/21/45
Contractor R. C. Patton Co.,

CASING RECORD.
10" O.D. L.W. Casing Set and
Cemented with 450 Sacks at 771Ft.
5 1/2" O.D. Casing Set and
Cemented with 450 Sacks at 4678Ft.

Lime & Shale	75
Red Bed	530
Shale & Shells	620
Shale	638
Shale & Red Bed	715
Lime & Shells	725
Anhydrite	735
Red Bed	789
Red Bed Gyp & Shells	850
Lime & Shale	1000
Red Rock	1190
Red Rock Shale & Salt	1435
Salt Shale & Gyp	1590
Lime	1625
Lime & Shale	1650
Shale & Shells	1790
Shale Lime & Shells	1880
Lime	2040
Lime Sandy	2100
Lime	2110
Lime & Shale	2330
Lime	2405
Shale	2430
Shale & Shells	2495
Shale & Lime	2560
Shale Lime & Shells	2660
Shale & Shells	2730
Shale	2820
Shale & Lime	2870
Lime	3420
Sand & Lime	3465
Lime	3880
Lime Broken	3915
Shale & Lime	3955
Lime	4030
Lime & Shale	4070
Lime K. C.	4145
Lime	4444
Lime Chat	4447
Lime	4456
Lime Chat & Shale	4489
Shale Chat	4509
Shale	4534
Lime	4537
Lime & Shale	4575
Lime Chat	4591
Lime	4629
Lime Shale	4655
Shale & Sand	4678
Shale	4741
Lime	4762
Dolomite	4785
Lime	4795 T. D.
Total Depth	4795

Handwritten mark

Handwritten signature

PLUGGING
 FILE 6 31 13W
 BOOK 77 36

STATE OF Kansas, COUNTY OF Sedgwick ss

I, the undersigned, being duly sworn, on oath state that the above statement and log is a true and correct record and log of the well drilled at the location above described.

R. C. Patton Co.,

By R. C. Patton

Subscribed and sworn to before me this 29th day of June 1945

My Commission Expires Oct 4th 1948

J. P. Hendrick
Notary Public.

NOTARY PUBLIC
 SEP 27 1946
 BARBER COUNTY, KANSAS