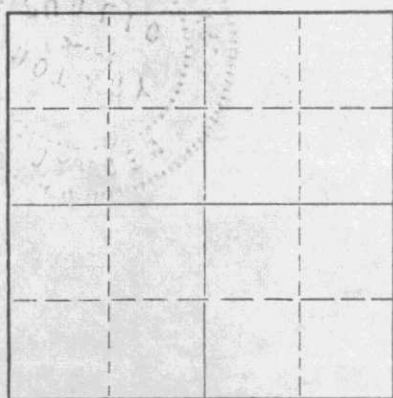


Give All Information Completely
Make Required Affidavit
Mail or Deliver Report to:
Conservation Division
State Corporation Commission
211 No. Broadway
Wichita, Kansas

WELL PLUGGING RECORD

NORTH

Locate well correctly on above
Section Plat

Barber County. Sec. 12 Twp. 31S Rge. 11W (E) (W)
Location as "NE/CNW/SW" or footage from lines C NW SE
Lease Owner E. K. Edmiston
Lease Name WARWICK-ALLENDER Well No. 1 (OWWO)
Office Address 425 First National Bank Bldg., Wichita, Ks.
Character of Well (completed as Oil, Gas or Dry Hole) dry hole
Date well completed October 12, 1965 19
Application for plugging filed on file with your office 19
Application for plugging approved 19
Plugging commenced February 4, 1966 19
Plugging completed February 7, 1966 19
Reason for abandonment of well or producing formation non-commercial

If a producing well is abandoned, date of last production -- 19
Was permission obtained from the Conservation Division or its agents before plugging was commenced? yes

Name of Conservation Agent who supervised plugging of this well Herman E. Justus
Producing formation ---- Depth to top Bottom Total Depth of Well 4519' Feet
Show depth and thickness of all water, oil and gas formations.

OIL, GAS OR WATER RECORDS

CASING RECORD

FORMATION	CONTENT	FROM	TO	SIZE	PUT IN	PULLED OUT
				2"	4519'	125 joints

Describe in detail the manner in which the well was plugged, indicating where the mud fluid was placed and the method or methods used in introducing it into the hole. If cement or other plugs were used, state the character of same and depth placed, from feet to feet for each plug set.

2/4/66 Raised and lined up mast. Made bottom hole plug back with sand to 4500. Mixed and ran 3 sacks cement thru dump bailer. Pulled 36" tension.
2/5/66 Made shots at 4060' - 3935'. Worked pipe after each shot. Worked pipe free. Pulled 75 joints.
2/6/66 Pulled 50 joints. (Total string 125 joints). Tallied pipe. Cleaned up bradenhead parts.
2/7/66 Mudded hole to 260' - set 10' rock bridge. Mixed and ran 25 sacks cement thru dump bailer. Mudded hole to 40' - set 10' rock bridge. Mixed and dumped 10 sacks cement to base of cellar. Tore down and loaded up. Cut off bradenhead.
(Information furnished by Southwest Casing Pulling Co.)

RECEIVED

(If additional description is necessary, use BACK of this sheet)

Name of Plugging Contractor Southwest Casing Pulling Co.
Address P. O. Box 364, Great Bend, Kansas

FEB 23 1966

STATE OF KANSAS, COUNTY OF SEDGWICK
E. K. Edmiston, owner
well, being first duly sworn on oath, says: That I have knowledge of the facts, statements, and matters herein contained and the log of the above-described well as filed and that the same are true and correct. So help me God.

(Signature)

E. K. Edmiston
425 First National Bank Building
Wichita, Kansas (Address)

Subscribed and Sworn to before me this 22nd day of February, 1966

My commission expires August 25, 1968

A. B. Bargen

Notary Public.