


STATE OF KANSAS
STATE CORPORATION COMMISSION
200 Colorado Derby Bldg.
Wichita, Kansas 67202

Form CP-4
Rev. 12-15-80

WELL PLUGGING RECORD

Give All Information Completely
Make Required Affidavit

COUNTY Barber SEC. 11 TWP. 31 RGE 11 XXE/W
Location as in quarters or footage from lines:
330' ESL & 2310' FEL

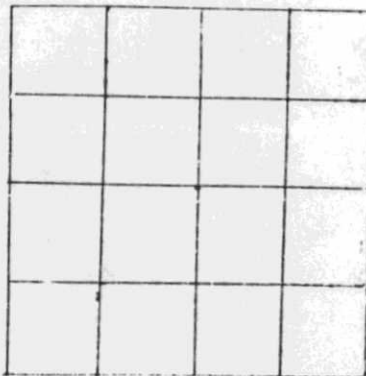

Locate Well
correctly on above
Section Platt.

Lease Owner TXO Production Corporation
Lease Name Brown-Roberson Well No. 1
Office Address 200 W. Douglas, Suite 300, Wichita, KS 67202
Character of Well (Completed as Oil, Gas or Dry Hole): Dry Hole
Date Well Completed November 4, 1983
Application for plugging filed Verbal application
Plugging commenced November 4, 1983
Plugging completed November 4, 1983
Reason for abandonment of well or producing formation

Dry Hole

Was permission obtained from the Conservation Division or it's
Agent's before plugging was commenced? Yes

Name of Conservation Agent who supervised plugging of this well Richard Lacey

Producing formation _____ Depth to top _____ bottom _____ T.D. 3990'

Show depth and thickness of all water, oil and gas formations.

OIL, GAS OR WATER RECORDS

Casing Record

Formation	Content	From	To	Size	Put in	Pulled Out
				8-5/8"	302'	

Describe in detail the manner in which the well was plugged, indicating where the mud fluid was placed and the method or methods used in introducing it into the hold. If cement or other plugs were used, state the character of same and depth placed, from _____ feet to _____ feet for each plug set.

40 sacks - 600'

40 sacks - 330'

10 sacks - 40'

10 sacks - MH

10 sacks - RH


5 sacks - well

(If additional description is necessary, use BACK of this sheet)

Name of Plugging Contractor Dowell, Div. of Dow Chemical
Hwy. 281 & Santa Fe, Pratt, KS 67124

STATE OF Kansas COUNTY OF Sedgwick, ss.

DIANE REBSTOCK, agent (~~employee~~ of owner) or (~~owner~~) of the
above-described well, being first duly sworn on oath, says: That I have knowledge of the
facts, statements, and matters herein contained and the log of the above-described well as
filed and that the same are true and correct. So help me God.

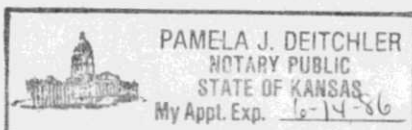

(Signature) Diane Rebstock
251 N. Water, #10, Wichita, Ks.
(Address) 67202

SUBSCRIBED AND SWORN TO before me this 14th day of November, 19 83

Pamela J. Deitchler
Pamela J. Deitchler - Notary Public

My Commission expires: June 14, 1986

RECEIVED
STATE CORPORATION COMMISSION

NOV 17 1983
11-17-83
CONSERVATION DIVISION
Wichita, Kansas