


Give All Information Completely
Make Required Affidavit
Mail or Deliver Report to:
Conservation Division
State Corporation Commission
211 No. Broadway
Wichita, Kansas

WELL PLUGGING RECORD

HARPER County. Sec. 7 Twp. 31 Rge. 8 (E) W (W)

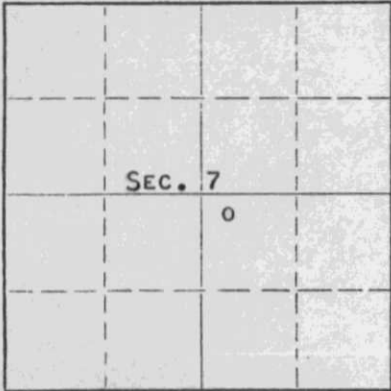

Locate well correctly on above Section Plat

Location as "NE/CNW/SW" or footage from lines NW NW SE
Lease Owner PETROLEUM INC.
Lease Name WINGATE Well No. 1
Office Address ROUTE 2, GREAT BEND, KANSAS
Character of Well (completed as Oil, Gas or Dry Hole) OIL
Date well completed MARCH 12 19 55
Application for plugging filed OCTOBER 22 19 56
Application for plugging approved OCTOBER 23 19 56
Plugging commenced DECEMBER 15 19 56
Plugging completed DECEMBER 26 19 56
Reason for abandonment of well or producing formation DEPLETION OF PRODUCIBLE ZONES
If a producing well is abandoned, date of last production AUGUST 28 19 56
Was permission obtained from the Conservation Division or its agents before plugging was commenced? YES

Name of Conservation Agent who supervised plugging of this well M.A. RIVES, PRATT, KANSAS
Producing formation MISSISSIPPI Depth to top 4372' Bottom --- Total Depth of Well 4500' Feet
Show depth and thickness of all water, oil and gas formations.

OIL, GAS OR WATER RECORDS

CASING RECORD

FORMATION	CONTENT	FROM	TO	SIZE	PUT IN	PULLED OUT
MISSISSIPPI	WATER AND LITTLE OIL	4380'	4400'	8 5/8" 4 1/2"	202' 4496'	NONE 3800'

Describe in detail the manner in which the well was plugged, indicating where the mud fluid was placed and the method or methods used in introducing it into the hole. If cement or other plugs were used, state the character of same and depth placed, from _____ feet to _____ feet for each plug set.
(PLUGGED BACK TO 4403')

FILLED HOLE WITH CRUSHED ROCK FROM 4403'-4370', AND PLACED 5 SACKS CEMENT ON TOP OF ROCK. MUDDED UP TO 200' AND PLACED SOLID ROCK BRIDGE ON TOP OF MUD. PLACED 20 SACKS CEMENT ON TOP OF ROCK BRIDGE AND MUDDED UP TO 30'. MADE SOLID ROCK BRIDGE AT 30' AND FILLED HOLE TO BASE OF WELL CELLAR WITH 10 SACKS CEMENT.

(If additional description is necessary, use BACK of this sheet)

Name of Plugging Contractor MORGAN WELL PLUGGING SERVICE
Address 102 WEST 18TH STREET, HUTCHINSON, KANSAS

STATE OF KANSAS, COUNTY OF BARTON, ss.
DON SEARLE (employee of owner) or (owner) of the above-described well, being first duly sworn on oath, says: That I have knowledge of the facts, statements, and matters herein contained and the log of the above-described well as filed and that the same are true and correct. So help me God.

(Signature) Don Searle
ROUTE 2, GREAT BEND, KANSAS
(Address)

SUBSCRIBED AND SWORN to before me this 5TH day of JANUARY, 19 57

My commission expires JULY 11, 1960

RECEIVED
STATE CORPORATION COMMISSION Notary Public.

PLUGGING
FILE SEC 7 T 31 R 8 W
BOOK PAGE 109 LINE 38

JAN 8 1957
1-8-57
CONSERVATION DIVISION
Wichita, Kansas

THE CARL TODD DRILLING COMPANY
404 KFH Building
Wichita, Kansas

PETROLEUM, INC.
#1 Wingate
NW NW SE Sec. 7-31S-8W
Harper County, Kansas

COMMENCED: February 7, 1955
COMPLETED: February 23, 1955

ELEVATION: 1635 DF

CASING RECORD

0 - 50	Sand with shale streaks
50 - 202	Red Bed and shells
202 - 1050	Shale, shells & Red Bed
1050 - 1470	Shale and shells
1470 - 1480	Shale and shells
1480 - 1500	Anhydrite
1500 - 1625	Shale and lime
1625 - 1720	Shale and lime
1720 - 1800	Lime and shale
1800 - 1950	Shale and lime
1950 - 2085	Shale and lime
2085 - 2275	Shale
2275 - 2490	Shale
2490 - 2660	Shale and shells
2660 - 2775	Lime and shale
2775 - 2940	Shale and lime
2940 - 3080	Shale and lime
3080 - 3155	Lime and shale
3155 - 3275	Shale and lime
3275 - 3360	Lime and shale
3360 - 3430	Shale and lime
3430 - 3490	Lime and shale
3490 - 3645	Shale and lime
3645 - 3705	Lime
3705 - 3757	Lime
3757 - 3820	Lime
3820 - 3881	Lime
3881 - 3946	Lime
3946 - 4005	Lime
4005 - 4050	Lime
4050 - 4096	Lime
4096 - 4160	Lime
4160 - 4215	Lime
4215 - 4255	Lime
4255 - 4310	Lime
4310 - 4367	Lime and shale
4367 - 4369	Lime
4369 - 4380	Chert
4380 - 4395	Chert
4395 - 4410	Chert
4410 - 4425	Chert
4425 - 4440	Chert
4440 - 4500	Chert
4500	Rotary Total Depth

8-5/8" 24# casing set at
202' with 165 sacks cement.

4-1/2" OD casing set at
4496' with 65 sacks cement,
12 sacks Stracreote, 4 sacks
Jel.

PLUGGING
FILE SEC 7 31 R 8W
BOOK PAGE 109 OF 38

RECEIVED
STATE CORPORATION COMMISSION
JAN 8 1957
1-8-57
CONSERVATION DIVISION
Wichita, Kansas

I hereby certify that the above is a true and correct log, to the best of my knowledge and belief.

THE CARL TODD DRILLING COMPANY

By: Carl Todd