


WELL PLUGGING RECORD

Give All Information Completely
Make Required Affidavit
Mail or Deliver Report to:
Conservation Division
State Corporation Commission
211 No. Broadway
Wichita, Kansas

NORTH

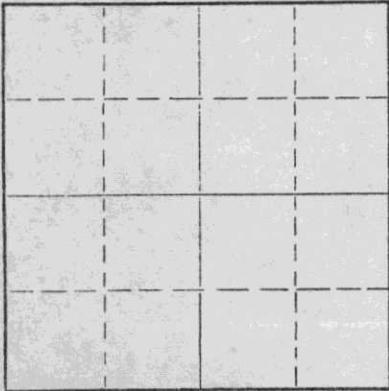

Locate well correctly on above
Section Plat

Harper County. Sec. 17 Twp. 31S Rge. 8 (E) (W) X
Location as "NE/CNW&SW" or footage from lines. SW SW SW
Lease Owner General American Oil Company of Texas
Lease Name Stodder Well No. 1
Office Address P. O. Box 1358 Seminole, Oklahoma
Character of Well (completed as Oil, Gas or Dry Hole) _____
Date well completed _____ 19____
Application for plugging filed _____ 19____
Application for plugging approved _____ 19____
Plugging commenced 2-17-66 _____ 19____
Plugging completed 2-21-66 _____ 19____
Reason for abandonment of well or producing formation _____

If a producing well is abandoned, date of last production _____ 19____
Was permission obtained from the Conservation Division or its agents before plugging was commenced? Yes

Name of Conservation Agent who supervised plugging of this well Archie V. Elving
Producing formation _____ Depth to top _____ Bottom _____ Total Depth of Well PB 4110 Feet
Show depth and thickness of all water, oil and gas formations.

OIL, GAS OR WATER RECORDS

CASING RECORD

FORMATION	CONTENT	FROM	TO	SIZE	PUT IN	PULLED OUT
				10 3/4	333	None
				7	None	3030

RECEIVED
STATE CORPORATION COMMISSION
3-1-66
MAR 1 1966
CONSERVATION DIVISION
Wichita, Kansas

Describe in detail the manner in which the well was plugged, indicating where the mud fluid was placed and the method or methods used in introducing it into the hole. If cement or other plugs were used, state the character of same and depth placed, from _____ feet to _____ feet for each plug set.

Moved in. Rigged up unit. Called out Halliburton Cement Truck - killed well with water. Pumped 50 sack plug down casing to shut off gas. Stopped plug at 4166'.

Cleaned out cellar. Working pipe.

Working pipe. Shot pipe at 3400' - 3300' - 3200' - 3100' & 3010'. Pulling pipe.

Pulling pipe.

Pulling pipe. Plugging well. Build rock bridge at 315'. Dumped 30 sacks of cement. Filled hole and rock bridge. Capped well with 15 sacks of cement.

(If additional description is necessary, use BACK of this sheet)

Name of Plugging Contractor Forbes Casing Pulling, Inc.
Address P. O. Box 221 Great Bend, Kansas

STATE OF Kansas, COUNTY OF Barton, ss.
J. O. Forbes (employee of owner) or (owner or operator) of the above-described well, being first duly sworn on oath, says: That I have knowledge of the facts, statements, and matters herein contained and the log of the above-described well as filed and that the same are true and correct. So help me God.

(Signature) J. O. Forbes
P. O. Box 221 Great Bend, Kansas
(Address)

SUBSCRIBED AND SWORN TO before me this 28 day of February, 1966

My commission expires May 27, 1969

Notary Public.

Stodder Estate Well No. 1

SW SW SW
Sec. 17-31S-8W
Harper County
Kansas

Contractor: The R. W. Rine Drilling Company
Started: 4/26/50 Finished 5/25/50

Surface Dirt	0- 10	
Sand	10- 100	
Red Bed	100- 185	
Red Bed & Sand	185- 337	
Reamed	0- 240	
Reamed	240- 335	10-3/4" osg. @ 335' w/ 250 Sx
Red Bed & Sand	335- 800	
Shale & Shells	800-1420	
Sand Lime - Shale	1420-1665	
Lime & Shale	1665-2270	
Shale	2270-2465	
Lime Shells-Shale	2465-2585	
Shale & Lime	2585-2880	
Lime	2880-2930	
Shale & Sand	2930-3090	
Lime	3090-3129	
Lime & Shale	3129-3440	
Lime	3440-3530	
Sand & Lime	3530-3680	
Lime	3680-3791	
Lime & Shale	3791-3942	
Lime	3942-3960	
Lime & Shale	3960-4000	
Chert, Lime & Shale	4000-4034	
Lime	4034-4240	
Lime & Shale	4240-4281	
Lime	4281-4356	
Shale Lime	4356-4384	
Shale	4384-4392	
Mississippi Lime	4392-4401	
Lime	4401-4416	
Chert	4416-4431	
Lime	4431-4451	
Mississippi Lime	4451-4491	
Lime	4481-4517	
Lime & Shale	4517-4546	
Lime	4546-4591	
Lime & Shale	4591-4753	
Lime	4753-4760	
Shale & Chert	4760-4803	
Shale & Sand	3803-4812	
Ream Core Hole	4812-4821	
Shale & Sand	4821-4931	
Shale & Lime	4931-4975	7" osg. @ 4541' w/ 200 Sx.
Tops Lansing	3634'	
Mississippi	4391'	
Viola	4753'	
Simpson	4809'	
Arbuckle	4940'	

RECEIVED
STATE CORPORATIONS COMMISSION

JAN 11 1966
1-11-66

CONSERVATION DIVISION
WICHITA, KANSAS

State of Kansas }
County of Sedgwick } ss

I, E. H. Sloyer, do hereby certify that the above is a true and accurate log of the Stodder Estate Well No. 1 located in the SW SW SW of Sec. 17-31S-8W, Harper County, Kansas.

E. H. Sloyer
Secretary

Subscribed to and sworn before me this 1st day of June, 1950.

E. M. Green
Notary Public