


STATE OF KANSAS
STATE CORPORATION COMMISSION

WELL PLUGGING RECORD

Give All Information Completely
Make Required Affidavit
Mail or Deliver Report to:
Conservation Division
State Corporation Commission
211 No. Broadway
Wichita, Kansas

NORTH

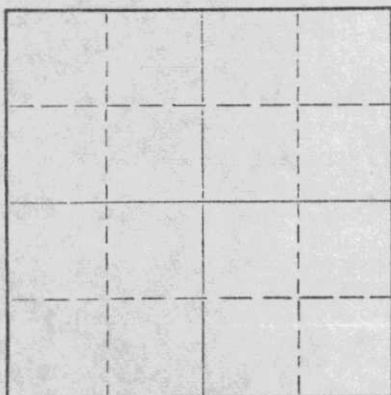

Locate well correctly on above
Section Plat

Harper County, Sec. 17 Twp. 31S Rge. 8 (E) (W) X
Location as "NE/CNW/SW" or footage from lines C of SE 1/4 of SE 1/4
Lease Owner Bulldog Pipe and Supply
Lease Name Albright Well No. 1
Office Address 309 Mayo Tulsa, Oklahoma
Character of Well (completed as Oil, Gas or Dry Hole)
Date well completed 19
Application for plugging filed 3-8-66 19
Application for plugging approved 3-10-66 19
Plugging commenced 3-12-66 19
Plugging completed 3-16-66 19
Reason for abandonment of well or producing formation Dry 19
If a producing well is abandoned, date of last production 3-21-66 19
Was permission obtained from the Conservation Division or its agents before plugging was commenced? Yes 19

RECEIVED
STATE CORPORATION COMMISSION
MAR 21 1966
3-21-66
CONSERVATION DIVISION
Wichita, Kansas

Name of Conservation Agent who supervised plugging of this well Archie V. Elving
Producing formation _____ Depth to top _____ Bottom _____ Total Depth of Well 1490 Feet
Show depth and thickness of all water, oil and gas formations.

OIL, GAS OR WATER RECORDS

CASING RECORD

FORMATION	CONTENT	FROM	TO	SIZE	PUT IN	PULLED OUT
				8 5/8	175	None
				5 1/2	None	3502

Describe in detail the manner in which the well was plugged, indicating where the mud fluid was placed and the method or methods used in introducing it into the hole. If cement or other plugs were used, state the character of same and depth placed, from _____ feet to _____ feet for each plug set.

Moved in. Rigged up. Made up bailer - ran to bottom. Sanded back to 1400'. Mixed and dumped 5 sacks of cement. Dug cellar. Unpacked braden head. Rigged up jacks. Took tension - had 23" at 25 Joints.

Andrews Water Service loaded hole. Ran weight - checked hole for shot. Shot pipe at 3722'. Working pipe. Shot pipe at 3506'. Working pipe.

Pulling pipe.

Pulling pipe. Bailed hole down from 30' to 175'. Set 10' rock bridge from 75' to 165'. Dumped 25 sacks of cement from 165' to 90'. Mudded hole to 40'. Set 10' rock bridge from 40' to 30'. Capped well with 10 sacks of cement from 30' to top of surface.

Tallied pipe. Tore down. Moved off location. Well completed.

(If additional description is necessary, use BACK of this sheet)

Name of Plugging Contractor Forbes Casing Pulling, Inc.
Address P. O. Box 221 Great Bend, Kansas

STATE OF Kansas, COUNTY OF Barton, ss.
J. O. Forbes (employee of owner) or (owner or operator) of the above-described well, being first duly sworn on oath, says: That I have knowledge of the facts, statements, and matters herein contained and the log of the above-described well as filed and that the same are true and correct. So help me God.

(Signature) J. O. Forbes
P. O. Box 221 Great Bend, Kansas
(Address)

SUBSCRIBED AND SWORN to before me this 18 day of March, 19 66

My commission expires May 27, 1969

Notary Public.