


15-887-00577-0000

Give All Information Completely
Make Required Affidavit
Mail or Deliver Report to:
Conservation Division
State Corporation Commission
800 Bitting Building
Wichita, Kansas

WELL PLUGGING RECORD

NORTH

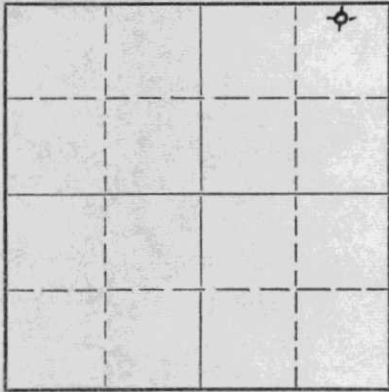

Locate well correctly on above
Section Plat

Barber County. Sec. 30 Twp. 30 Rge. 14 (W)
Location as "NE/CNW $\frac{1}{2}$ SW $\frac{1}{2}$ " or footage from lines CN/2 NE NE
Lease Owner W. J. Coppinger
Lease Name McLain Well No. 2
Office Address 320 Union Nat'l Bank Bldg., Wichita, Kansas
Character of Well (completed as Oil, Gas or Dry Hole) Dry Hole
Date well completed 12-30 19 53
Application for plugging filed 12-30 19 53
Application for plugging approved 12-30 19 53
Plugging commenced 12-30 19 53
Plugging completed 12-31 19 53
Reason for abandonment of well or producing formation _____

If a producing well is abandoned, date of last production _____ 19 _____
Was permission obtained from the Conservation Division or its agents before plugging was commenced? Yes

Name of Conservation Agent who supervised plugging of this well M. A. Rives, Pratt, Kansas.
Producing formation _____ Depth to top _____ Bottom _____ Total Depth of Well 4625 Feet
Show depth and thickness of all water, oil and gas formations.

OIL, GAS OR WATER RECORDS

CASING RECORD

FORMATION	CONTENT	FROM	TO	SIZE	PUT IN	PULLED OUT

Describe in detail the manner in which the well was plugged, indicating where the mud fluid was placed and the method or methods used in introducing it into the hole. If cement or other plugs were used, state the character of same and depth placed, from _____ feet to _____ feet for each plug set.
Filled hole to 300' of top.
Pushed plug down to 300'.
Cemented with 20 sacks.
Filled hole to 40' of top.
Cemented with 10 sacks.

(If additional description is necessary, use BACK of this sheet)

Name of Plugging Contractor Coppinger Drilling, Inc.
Address 320 Union National Bank Building, Wichita 2, Kansas.

STATE OF KANSAS, COUNTY OF SEDGWICK, ss.
Lee Poulsen (employee of owner) or (~~owner or operator~~) of the above-described well, being first duly sworn on oath, says: That I have knowledge of the facts, statements, and matters herein contained and the log of the above-described well as filed and that the same are true and correct. So help me God.

(Signature) Lee Poulsen
320 Union National Bank Bldg., Wichita, Kansas.
(Address)

SUBSCRIBED AND SWORN TO before me this 4th day of January, 19 54
Wayne Broadus
Notary Public.

My commission expires March 7, 1956

PLUGGING
FILE SEC 30 T 30 R 14W
BOOK PAGE 4 LINE 28

RECEIVED
STATE CORPORATION COMMISSION
JAN 7 - 1954
1-7-54
CONSERVATION DIVISION
Wichita, Kansas

W. J. COPPINGER
320 Union Natl Bk Building
Wichita, Kansas

December 31, 1953

D R I L L E R S L O G

Operator: W. J. Coppinger
 Wichita, Kansas

Contractor: Coppinger Drilling, Inc.

Re: McLain #2
 C N/2 NE NE
 Section 30-30S-14W
 Barber County, Kansas
 (10' south and west
 of original hole:
 McLain #1)

Clay and rock	65
Sand	110
Red bed and shale	440
Red bed	600
Shale and red bed	760
Anhydrite	779
Shale and red bed	890
Shale and shells	1320
Shale	1340
Salt	1400
Shale	1750
Lime, shale and shells	1820
Shale and shells	1935
Shale and lime	2025
Lime	2140
Lime and shale	2180
Shale	2265
Lime and shale	2420
Shale	2515
Shale and lime	2785
Shale	3040
Lime and shale	3200
Lime	3675
Lime and shale	3915
Shale	3919
Lime	3975
Shale and lime	3990
Lime	4060
Lime and shale	4110
Lime	4320
Lime and shale	4395
Shale	4420
Brown lime	4440
Lime and chert	4470
Shale and chert	4494
Lime and sand	4507
Shale and sand	4602
Lime	4625
 R T D	 4625

Casing record:
8-5/8" set at 780' with 470 sx.

Tops:

Topeka	3029
Heebner	3729
Toronto	3749
Douglas Sand	3798
Brown Lansing	3904
Base K.C.	4301
Conglomerate	4428
Viola Chert	4454
Simpson Sand	4496
rbuckle	4602
R T D	4625

Lane 3919

Commenced: 11-28-53
Completed: 12-30-53
Elevation: 1797 D.F.

Dry and abandoned.

STATE OF KANSAS)
COUNTY OF SEDGWICK) ss.



I, Lee Poulsen, the undersigned geologist, being duly sworn on oath state that the above statement and log is a true record and log of the well drilled at the location above described.

Lee Poulsen

Lee Poulsen, Geologist

Subscribed and sworn to before me this 31st day of December, 1953.

Mayeel Broadbent

Notary Public

My commission expires: March 7, 1956

PLUGGING

FILE SEC 30 T 30 R 14W

BOOK PAGE 4 LINE 28

RECEIVED
STATE COMMISSION
JAN 7 - 1954
1-7-54
CONSERVATION DIVISION
Wichita, Kansas