


STATE OF KANSAS
STATE CORPORATION COMMISSION

Form CP-4

Give All Information Completely
Make Required Affidavit
Mail or Deliver Report to:
Conservation Division
State Corporation Commission
212 No. Market
Wichita, Kansas 67202

WELL PLUGGING RECORD

Location as "NE/CNW/SE/SW" or footage from lines 16 335- 10-N
Barber County, Sec 335 Twp 10-N Rge. 335 (E) (W)
Location as "NE/CNW/SE/SW" or footage from lines S.W. = S.E.
Lease Owner J.R. Taylor
Lease Name Schooly Well No. ?
Office Address 2612 Elmhurst Oklahoma City, Okla. 73120
Character of Well (completed as Oil, Gas or Dry Hole) Non-Commercial Gas Well
Date well completed January 30, 1969
Application for plugging filed Oct. 26 1969
Application for plugging approved Oct. 27 1969
Plugging commenced 10-27 1969
Plugging completed Nov 11-5 1969
Reason for abandonment of well or producing formation No Commercial Production
If a producing well is abandoned, date of last production November 1969
Was permission obtained from the Conservation Division or its agents before plugging was commenced? Yes

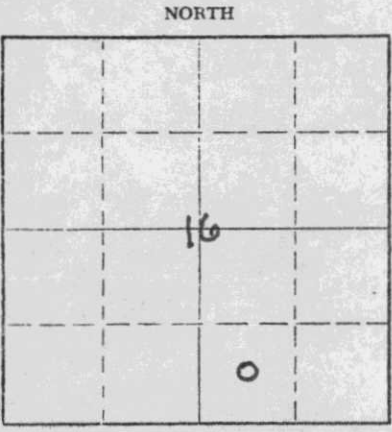

Locate well correctly on above Section Plat

Name of Conservation Agent who supervised plugging of this well Russell Beberstien
Producing formation Missipi Chat Depth to top 4503 Bottom 4515 Total Depth of Well 4537 Feet
Show depth and thickness of all water, oil and gas formations.

OIL, GAS OR WATER RECORDS

CASING RECORD

FORMATION	CONTENT	FROM	TO	SIZE	PUT IN	PULLED OUT
<u>Missipi Chat</u>	<u>Gas</u>	<u>4503</u>	<u>4515</u>	<u>8 3/4</u> <u>4 1/2</u>	<u>310</u> <u>4536</u>	<u>NONE</u> <u>3991</u>

Describe in detail the manner in which the well was plugged, indicating where the mud fluid was placed and the method or methods used in introducing it into the hole. If cement or other plugs were used, state the character of same and depth placed, from _____ feet to _____ feet for each plug set.

Dump Sand in = Sand From 4536 - 4494
Dumped 3 sacks cement with backer From 4494 = 4470
Riped pipe at 3991. Pulled out
Build Rock Bridge in 8 3/4 = 10 feet - From 270 to 260
Dumped 4 yards of ready mix cement to plug off surface pipe

RECEIVED
STATE CORPORATION COMMISSION
NOV 22 1971
CONSERVATION DIVISION
Wichita, Kansas
11-22-1971

(If additional description is necessary, use BACK of this sheet)
Name of Plugging Contractor Clarke Corp.
Address Box 107 Medicine Lodge, Kansas

STATE OF Oklahoma COUNTY OF Tulsa, ss.
J.R. Taylor (employee of owner) or (owner or operator) of the above-described

well, being first duly sworn on oath, says: That I have knowledge of the facts, statements, and matters herein contained and the log of the above-described well as filed and that the same are true and correct. So help me God.

(Signature) J.R. Taylor
2612 Elmhurst (Address)

SUBSCRIBED AND SWORN TO before me this 19th day of November, 1971.

Louise B. Reid
Notary Public.

My commission expires 9-16-72