


STATE OF KANSAS
 STATE CORPORATION COMMISSION
 CONSERVATION DIVISION
 P. O. BOX 17027
 WICHITA, KANSAS 67217

FORM CP-4

WELL PLUGGING RECORD

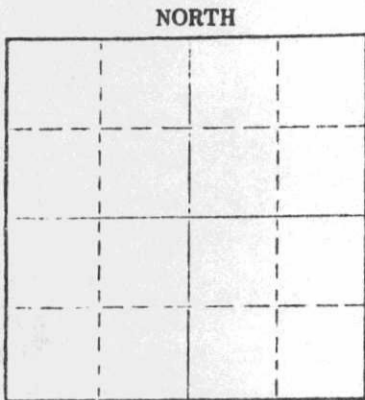

Barber County. Sec. 15 Twp. 33S Rge. (E) 12 (W)
 Location as "NE/CNWSW" or footage from lines NE NE NW
 Lease Owner Okmar Oil Company
 Lease Name Rachel Well No. 1
 Office Address 970 Fourth Financial Center- Wichita, Kansas
 Character of Well (completed as Oil, Gas or Dry Hole) dry hole
 Date well completed April 19, 1976
 Application for plugging filed April 19, 1976
 Application for plugging approved April 19, 1976
 Plugging commenced April 19, 1976
 Plugging completed April 19, 1976
 Reason for abandonment of well or producing formation Dry Hole

If a producing well is abandoned, date of last production 19
 Was permission obtained from the Conservation Division or its agents before plugging was commenced? yes

Name of Conservation Agent who supervised plugging of this well George Russell Bieberstein
 Producing formation Depth to top Bottom Total Depth of Well 4563 Feet
 Show depth and thickness of all water, oil and gas formations.

OIL, GAS OR WATER RECORDS

CASING RECORD

FORMATION	CONTENT	FROM	TO	SIZE	PUT IN	PULLED OUT
	Surface					
	Casing	0	424'	8 5/8"	424'	none

Describe in detail the manner in which the well was plugged, indicating where the mud fluid was placed and the method or methods used in introducing it into the hole. If cement or other plugs were used, state the character of same and depth placed, from feet to feet for each plug set.

Heavy mud from total depth to 300 feet
 35 sacks cement, plug at 40' with 15
 sacks of cement to ground level or
 bottom of cellar, 2 sacks cement in rathole.
 Job completed at 12:30 P.M., 4-19-76.

(If additional description is necessary, use BACK of this sheet)

Name of Plugging Contractor Allied Cement Company
 Address Russell, Kansas

STATE OF Kansas COUNTY OF Sedgwick ss.
 R. M. Wendling (employee of owner) or (owner or operator) of the above-described well, being first duly sworn on oath, says: That I have knowledge of the facts, statements, and matters herein contained and the log of the above-described well as filed and that the same are true and correct. So help me God.

(Signature) *R. M. Wendling*
 Wichita, Kansas (Address)

SUBSCRIBED AND SWORN TO before me this 19th. day of April, 1976

My commission expires February 19, 1976
Maxine Dressen
 Maxine Dressen Notary Public.

MAXINE DRESSEN
 NOTARY PUBLIC
 SEDGWICK COUNTY, KANSAS
 MY COMM. EXP. FEB. 19, 1977

RECEIVED
 STATE CORPORATION COMMISSION
 APR 21 1976
 CONSERVATION DIVISION
 Wichita, Kansas

DRILLERS LOG

Rachel #1

<u>CASING RECORD:</u> 8 5/8" set at 424' w/ 195 sacks cement	<u>OPERATOR:</u> Okmar Oil Company	<u>DESCRIPTION:</u> NE NE NW, Section 15-33S-12W Barber County, Kansas
<u>TOTAL DEPTH</u> 4563'	<u>CONTRACTOR:</u> Search Drilling Company	
	<u>COMMENCED:</u> April 6, 1976	
	<u>COMPLETED:</u> April 19, 1976	

<u>FORMATION</u>	<u>FROM</u>	<u>TO</u>	<u>REMARKS</u>
Shale - Gyp	0	360	
Shale	360	427	
Shale	427	1666	
Lime and Shale	1666	2236	
Shale and Lime	2236	2376	
Lime and Shale	2376	2504	
Shale and Lime	2504	2638	
Lime and Shale	2638	2857	
Lime	2857	2990	
Lime and Shale	2990	3370	
Shale and Lime	3370	3523	
Lime and Shale	3523	3638	
Sand and Shale	3638	3670	
Lime and Shale	3670	3949	
Shale and Lime	3949	4029	
Lime and Shale	4029	4519	
Lime	4519	4563	
Total Depth	4563		Dry and Abandoned

RECEIVED
STATE CORPORATION COMMISSION
APR 21 1976
CONSERVATION DIVISION
Wichita, Kansas

I certify that this is a true and correct copy of the above log to the best of my knowledge.

SEARCH DRILLING COMPANY

R. M. Wendling
R. M. Wendling

Subscribed and sworn to before me this 16th day of April, 1976.

My commission expires:
February 19, 1976

Maxine Dressen
Maxine Dressen Notary Public

MAXINE DRESSEN
NOTARY PUBLIC
SEDGWICK COUNTY, KANSAS
MY COMM. EXP. FEB. 19, 1977