


STATE OF KANSAS
STATE CORPORATION COMMISSION

Give All Information Completely
Make Required Affidavit
Mail or Deliver Report to:
Conservation Division
State Corporation Commission
212 No. Market
Wichita, Kansas

WELL PLUGGING RECORD

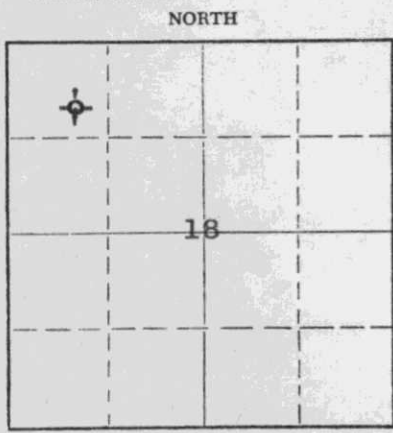

Locate well correctly on above
Section Plat

Barber County, Sec. 18 Twp. 31S Rge. 15Wxxx (W)

Location as "NE/CNW/SW" or footage from lines 1250' FNL 1250' FWL
Lease Owner Texas Oil & Gas Corporation
Lease Name Rusk Well No. 1
Office Address 200 W. Douglas, Wichita, Kansas 67202
Character of Well (completed as Oil, Gas or Dry Hole) Dry Hole
Date well completed June 9, 19 74
Application for plugging filed June 9, 19 74
Application for plugging approved June 9, 19 74
Plugging commenced June 9, 19 74
Plugging completed June 9, 19 74
Reason for abandonment of well or producing formation Dry Hole.

If a producing well is abandoned, date of last production 19
Was permission obtained from the Conservation Division or its agents before plugging was commenced? Yes

Name of Conservation Agent who supervised plugging of this well
Producing formation Depth to top Bottom Total Depth of Well 4879 Feet
Show depth and thickness of all water, oil and gas formations.

OIL, GAS OR WATER RECORDS

CASING RECORD

FORMATION	CONTENT	FROM	TO	SIZE	PUT IN	PULLED OUT
		0	600'	8-5/8"	600'	None

Describe in detail the manner in which the well was plugged, indicating where the mud fluid was placed and the method or methods used in introducing it into the hole. If cement or other plugs were used, state the character of same and depth placed, from feet to feet for each plug set.

Hole filled with Mud 4879-360'
Plug 360-356'
50 sacks Cement 356-40'
Plug 40-36'
20 sacks Cement 36-6'
5 sacks cement in rat hole.

RECEIVED
STATE CORPORATION COMMISSION
JUN 17 1974
CONSERVATION DIVISION
Wichita, Kansas

Name of Plugging Contractor Dowell (If additional description is necessary, use BACK of this sheet)
Address

STATE OF KANSAS, COUNTY OF SEDGWICK, ss.
John H. Knightley (Agent) of the above-described well, being first duly sworn on oath, says: That I have knowledge of the facts, statements, and matters herein contained and the log of the above-described well as filed and that the same are true and correct. (So help me God.)

(Signature) John H. Knightley
301 S. Broadway, Wichita, Kansas (Address)

SUBSCRIBED AND SWORN TO before me this 14th day of June, 19 74

My commission expires March 12, 1975 Stella J. Lips Notary Public.

Texas Oil & Gas Corp. - Rusk #1
1250' FNL 1250' FWL Sec. 18-31S-15W
Barber County, Kansas

Contractor: D. R. Lauck Oil Company, Inc.
301 S. Broadway
Wichita, Kansas 67202

Commenced: May 23, 1974
Completed: June 9, 1974

Drillers Log

Clay & Shale	115
Gyp	130
Shale & Red Bed	385
Sand	400
Red Bed	550
Shale & Shells	1358
Shale	1383
Shale & Shells	1760
Lime & Shale	2455
Shale & Lime	3330
Lime & Shale	4190
Lime	4879 RTD

RECEIVED
STATE CORPORATION COMMISSION
JUN 17 1974
CONSERVATION DIVISION
Wichita, Kansas