


STATE OF KANSAS
STATE CORPORATION COMMISSION

WELL PLUGGING RECORD

Give All Information Completely
Make Required Affidavit
Mail or Deliver Report to:
Conservation Division
State Corporation Commission
211 No. Broadway
Wichita, Kansas

NORTH

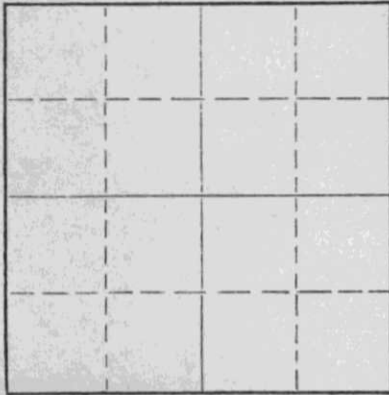

Locate well correctly on above
Section Plat

Barber County. Sec. 21 Twp. 31S Rge. (E) 15 (W)

Location as "NE/CNW/SW" or footage from lines. NW NW NE
Lease Owner JOHN O. FARMER, INC.
Lease Name HULL Well No. 1
Office Address Russell, Kansas
Character of Well (completed as Oil, Gas or Dry Hole) Dry
Date well completed 7/21 19 59
Application for plugging filed 7/21 19 59
Application for plugging approved 7/21 19 59
Plugging commenced 7/21 19 59
Plugging completed 7/21 19 59
Reason for abandonment of well or producing formation Dry

If a producing well is abandoned, date of last production _____ 19____
Was permission obtained from the Conservation Division or its agents before plugging was commenced? yes

Name of Conservation Agent who supervised plugging of this well W. L. Lackamp, Stafford, Kansas
Producing formation _____ Depth to top _____ Bottom _____ Total Depth of Well 4900 Feet
Show depth and thickness of all water, oil and gas formations.

OIL, GAS OR WATER RECORDS

CASING RECORD

FORMATION	CONTENT	FROM	TO	SIZE	PUT IN	PULLED OUT
				8-5/8"	280*	None

Describe in detail the manner in which the well was plugged, indicating where the mud fluid was placed and the method or methods used in introducing it into the hole. If cement or other plugs were used, state the character of same and depth placed, from _____ feet to _____ feet for each plug set.

First plug set at 270 feet with 1/2 sack hulls and 20 sacks cement thru drill pipe

Second plug set at 35 feet with 10 sacks cement

RECEIVED
STATE CORPORATION COMMISSION
JUL 29 1959
CONSERVATION DIVISION
Wichita, Kansas

(If additional description is necessary, use BACK of this sheet)

Name of Plugging Contractor JOHN O. FARMER, INC.
Address Russell, Kansas

STATE OF Kansas, COUNTY OF Russell, ss.
I, JOHN O. FARMER (owner or operator) of the above-described well, being first duly sworn on oath, says: That I have knowledge of the facts, statements, and matters herein contained and the log of the above-described well as filed and that the same are true and correct. So help me God.

(Signature) John O. Farmer
Russell, Kansas
(Address)

SUBSCRIBED AND SWORN TO before me this 25th day of July, 19 59

My commission expires October 11, 1962
Lucille Kennedy Notary Public.

PLUGGING
FILE SEC. R. I. T. 31 R. 154
BOOK PAGE 56 LINE 2


PLUGGING
FILE SEC 2 L T 31 R 152
BOOK PAGE 56 LINE 2

Describe here with words or flow diagram, layout of field or its features.




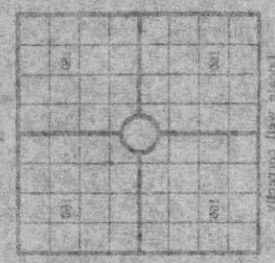



