

15-007-2094-00-00


STATE OF KANSAS
STATE CORPORATION COMMISSION

WELL PLUGGING RECORD

Give All Information Completely
Make Required Affidavit
Mail or Deliver Report to
Conservation Division
State Corporation Comm.
245 North Water
Wichita, KS 67202

Barber County, Sec. 24 Twp. 31S Rge. 15W E/W
Location as "NE/CNW $\frac{1}{4}$ SW $\frac{1}{4}$ " or footage from lines
2180 FSL - 1320 FWL

Lease Owner Texas Oil & Gas Corporation
Lease Name Hull "F" Well No. 1
Office Address 200 West. Douglas, Suite 300, Wichita, Kansas
Character of Well (Completed as Oil, Gas or Dry Hole) Dry Hole

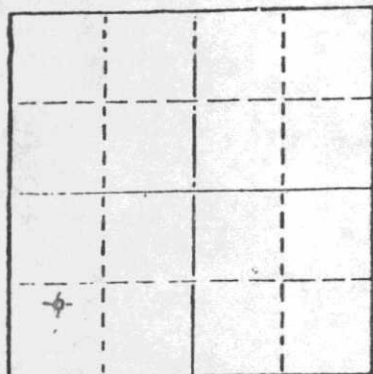

Locate well correctly on above
Section Plat

Date Well completed 4-21 1980
Application for plugging filed 4-21 1980
Application for plugging approved 4-21 1980
Plugging commenced 4-21 1980
Plugging completed 4-21 1980
Reason for abandonment of well or producing formation Dry Hole

If a producing well is abandoned, date of last production 19

Was permission obtained from the Conservation Division or its agents before plugging was commenced? Yes

Name of Conservation Agent who supervised plugging of this well Bill Owen
Producing formation _____ Depth to top _____ Bottom _____ Total Depth of Well _____
Show depth and thickness of all water, oil and gas formations.

OIL, GAS OR WATER RECORDS

CASING RECORD

FORMATION	CONTENT	FROM	TO	SIZE	PUT IN	PULLED OUT
		0	975'	8 5/8"	24jts.	

Describe in detail the manner in which the well was plugged, indicating where the mud fluid was placed and the method or methods used in introducing it into the hold. If cement or other plugs were used, state the character of same and depth placed, from _____ feet to _____ feet for each plug set. Plugged at 600' with 50 sacks common cement, and at 40 feet with 10 sacks of common cement, cement circulated

RECEIVED
STATE CORPORATION COMMISSION
APR 29 1980
CONSERVATION DIVISION
Wichita, Kansas

(If additional description is necessary, use BACK of this sheet)

Name of Plugging Contractor Halliburton

STATE OF Kansas COUNTY OF Sedgwick, ss.
(employee of owner) or (owner or operator)
of the above-described well, being first duly sworn on oath, says: That I have knowledge of the facts, statements, and matters herein contained and the log of the above-described well as filed and that the same are true and correct. So help me God.

(Signature) Kirby C. Evers
P.O. Box 18611, Wichita, Kansas 67202
(Address)

SUBSCRIBED AND SWORN TO before me this 28th day of April, 1980.

My commission expires MY APPOINTMENT EXPIRES NOV 28, 1980
Mary Kay Odeniz Notary Public.

WELL LOG

OPERATOR: Texas Oil & Gas Corporation
CONTRACTOR: Xplor Drilling Company

COMMENCED: April 6, 1980
COMPLETED: April 22, 1980
CASING RECORD: 8 5/8" @ 975'

<u>FORMATION</u>	<u>FROM</u>	<u>TO</u>
Red Bed	0	2700
Lime & Shell	2700	4775

STATE OF KANSAS)
) SS:
COUNTY OF SEDGWICK)

RECEIVED
STATE CORPORATION COMMISSION
APR 29 1980
CONSERVATION DIVISION
Wichita, Kansas

I certify that this is a true and correct copy of the Driller's Log on the well drilled 2180 FSL - 1320 FWL, Sec. 24-31S-15W, Barber County to the best of my knowledge and belief.



XPLOR DRILLING COMPANY

Kirby C. Evers
Kirby C. Evers, Vice President

Subscribed and sworn to before me this 28th of April, 1980.

Mary Kay Oeding

My appointment expires: MY APPOINTMENT EXPIRES NOV 28, 1980