

STATE OF KANSAS  
STATE CORPORATION COMMISSION

Form CP-4

Give All Information Completely  
Make Required Affidavit  
Mail or Deliver Report to:  
Conservation Division  
State Corporation Commission  
212 No. Market  
Wichita, Kansas

WELL PLUGGING RECORD

Barber County, Sec. 24 Twp. 31S Rge. 15W (E) (W)

Location as "NE/CNW/SW" or footage from lines SW SE

Lease Owner Ferguson Oil Company

Lease Name Hull Well No. 1

Office Address 1505 Wichita Plaza Building - Wichita, Kansas 67202

Character of Well (completed as Oil, Gas or Dry Hole) Dry Hole

Date well completed April 2 19 68

Application for plugging filed 4-2-68 19

Application for plugging approved 4-2-68 19


Plugging commenced 4-2-68 19

Plugging completed 4-2-68 19

Reason for abandonment of well or producing formation commercial quantities of oil not found

If a producing well is abandoned, date of last production 19

Was permission obtained from the Conservation Division or its agents before plugging was commenced? yes

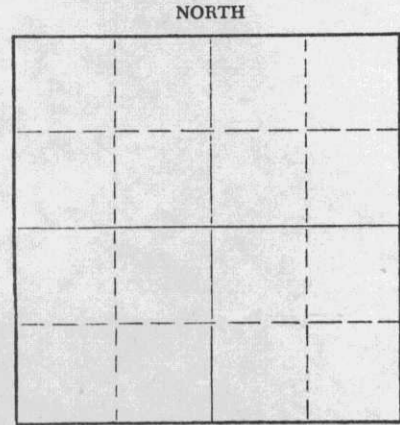

Locate well correctly on above Section Plat

Name of Conservation Agent who supervised plugging of this well Herman Justus

Producing formation Depth to top Bottom Total Depth of Well 4886 Feet

Show depth and thickness of all water, oil and gas formations.

OIL, GAS OR WATER RECORDS

CASING RECORD

FORMATION	CONTENT	FROM	TO	SIZE	PUT IN	PULLED OUT
				8 5/8"	248'	None

Describe in detail the manner in which the well was plugged, indicating where the mud fluid was placed and the method or methods used in introducing it into the hole. If cement or other plugs were used, state the character of same and depth placed, from feet to feet for each plug set.

Bottom Plug @ 240' w/ 25 sacks  
Top Plug @ 30' w/ 10 sacks  
2 sacks for rathole

RECEIVED  
STATE CORPORATION COMMISSION  
APR 9 1968  
CONSERVATION DIVISION  
Wichita, Kansas

(If additional description is necessary, use BACK of this sheet)

Name of Plugging Contractor Walters Drilling Co.

Address 400 Insurance Building - Wichita, Kansas 67202

STATE OF KANSAS, COUNTY OF SEDGWICK, ss. contractor Robert F. Walters

well, being first duly sworn on oath, says: That I have knowledge of the facts, statements, and matters herein contained and the log of the above-described well as filed and that the same are true and correct. So help me God.

(Signature) X [Signature]

400 Insurance Building - Wichita, Kansas 67202 (Address)

Subscribed and sworn to before me this 8th day of April 19 68

My commission expires October 4, 1971

[Signature] Notary Public.



DRILLER'S LOG

COMPANY: FERGUSON OIL COMPANY  
1505 Wichita Plaza Building  
Wichita, Kansas 67202

WELL NAME: HULL #1  
SW SE SECTION 24-31S-15W  
Barber County, Kansas

CONTRACTOR: WALTERS DRILLING CO.  
400 Insurance Building  
Wichita, Kansas 67202

ROTARY DRILLING COMMENCED: MARCH 19, 1968  
ROTARY DRILLING COMPLETED: APRIL 2, 1968

ELEVATION: 1761 KB

CASING RECORD: 8 5/8" @ 248' w/ 175 sacks cement

LOG


0 - 120	Surface Rock and Shale
120 - 250	Surface Rock and Shale
250 - 925	Red Bed and Shale
925 - 1219	Shale
1219 - 1310	Shale
1310 - 1887	Shale and Shells
1887 - 2080	Shale and Lime Streaks
2080 - 3065	Lime and Shale
3065 - 3365	Shale and Lime
3365 - 3800	Lime and Shale
3800 - 4035	Lime
4035 - 4080	Lime and Shale
4080 - 4572	Lime
4572 - 4675	Cherty Lime
4675 - 4760	Lime
4760 - 4875	Lime and Chert
4875 - 4886	Lime
<u>4886</u>	<u>Rotary Total Depth</u>

RECEIVED  
STATE CORPORATION COMMISSION  
APR 9 1968  
CONSERVATION DIVISION  
Wichita, Kansas

The undersigned, Robert F. Walters, hereby certifies, in behalf of said company that the above log is a true and correct log of the formations encountered in drilling the above well as reflected by the Daily Drilling Reports.

WALTERS DRILLING CO.

BY

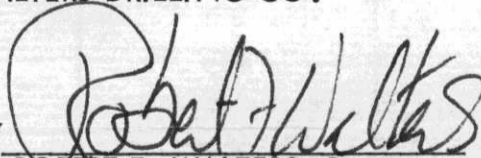  
ROBERT F. WALTERS, Partner

Subscribed and sworn to before me  
this 8th day of April, 1968.

