


WELL PLUGGING RECORD

Give All Information Completely
Make Required Affidavit
Mail or Deliver Report to:
Conservation Division
State Corporation Commission
800 Bitting Building
Wichita, Kansas

Barber County, Sec. 24 Twp. 31 Rge. 15 (E) (W)

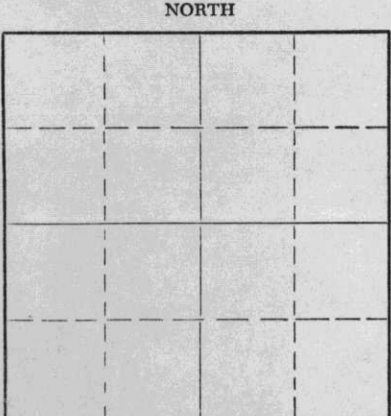

Locate well correctly on above Section Plat

Location as "NE/CNW%SW%" or footage from lines NE NE NE
Lease Owner Musgrove Petroleum Corporation
Lease Name Dickerson Well No. 1
Office Address 518 Petroleum Building, Wichita, Kansas
Character of Well (completed as Oil, Gas or Dry Hole) Oil, Feb. 23, 1953
Date well completed March 15, 19 53
Application for plugging filed March 2, 19 53
Application for plugging approved March 3, 19 53
Plugging commenced March 14, 19 53
Plugging completed March 15, 19 53
Reason for abandonment of well or producing formation Dry

If a producing well is abandoned, date of last production _____ 19 ____
Was permission obtained from the Conservation Division or its agents before plugging was commenced? Yes

Name of Conservation Agent who supervised plugging of this well M.A. Rives
Producing formation _____ Depth to top _____ Bottom _____ Total Depth of Well 4840' Feet
Show depth and thickness of all water, oil and gas formations.

OIL, GAS OR WATER RECORDS

CASING RECORD

FORMATION	CONTENT	FROM	TO	SIZE	PUT IN	PULLED OUT
				8 5/8"	861'	
				5 1/2"	4668'	3830'

Describe in detail the manner in which the well was plugged, indicating where the mud fluid was placed and the method or methods used in introducing it into the hole. If cement or other plugs were used, state the character of same and depth placed, from _____ feet to _____ feet for each plug set.

Filled back in sand from 3629' to 4525' dumped 5 sacks of cement, mudded up to 300' put in 10' rock bridge ran 20 sacks of cement, mudded to 35' put in 5' rock bridge with 10 sacks of cement this filled to top of surface.

(If additional description is necessary, use BACK of this sheet)

Name of Plugging Contractor Musgrove Petroleum Corporation
Address 518 Petroleum Building, Wichita, Kansas

STATE OF KANSAS, COUNTY OF SEDGWICK, ss.
Gordon L. Koelling (employee of owner) or (owner or operator) of the above-described well, being first duly sworn on oath, says: That I have knowledge of the facts, statements, and matters herein contained and the log of the above-described well as filed and that the same are true and correct. So help me God.

(Signature) Gordon L. Koelling
518 Petroleum Building, Wichita, Kansas
(Address)

SUBSCRIBED AND SWORN TO before me this 23rd day of March, 19 53

My commission expires November 14, 1956 Mary L. Rumm Notary Public.

PLUGGING
FILE SEC. 24 TWP. 31 R. 1524
BOOK PAGE 62 LINE 7

RECEIVED
STATE CORPORATION COMMISSION
MAR 24 1953
CONSERVATION DIVISION
Wichita, Kansas

CONTRACTOR'S WELL LOG

COMPANY: Musgrove Petroleum Corporation
CONTRACTOR: Musgrove Petroleum Corporation
FARM: Dickerson #1
LOCATION: NE NE NE Section 24-31-15
Barber County, Kansas

COMMENCED: January 13, 1953
COMPLETED: February 9, 1953

0	40	Clay
40	660	Red bed and shells
660	670	Red bed
670	735	Anhydrite
735	850	Lime and shale
850	1795	Shale and shells
1795	2010	Shale, shells and lime
2010	2920	Lime and shale
2920	3320	Lime
3320	4210	Lime and shale
4210	4250	Lime
4250	4401	Lime and shale
4401	4810	Lime
4810	4840	Arbuckle
	4840	Rotary Total Depth

Set 861' of 8 5/8", cemented with 100 sacks of cement.

Set 5 1/2" at 4668', cemented with 125 sacks of cement.

STATE OF KANSAS)
) SS
COUNTY OF SEDGWICK)

I, GORDON L. KOELLING, do hereby certify that the above and foregoing is a true and correct copy of the log of the Dickerson #1, NE NE NE, Section 24-31-15, Barber County, Kansas, as reflected by the files of the Musgrove Petroleum Corporation.

MUSGROVE PETROLEUM CORPORATION

By Gordon L. Koelling
Secretary-Treasurer

Subscribed and sworn to before me a Notary Public in and for Sedgwick County, Kansas, this 16th day of February, 1953.

Mary L. Dunn
Notary Public

My Commission Expires: November 14, 1956.

RECEIVED
COMMISSION
FEB 17 1953
CONSERVATION DIVISION
Wichita, Kansas

PLUGGING
FILE SEC 24 T 31 R 15 W
BOOK PAGE 82 LINE 7