


STATE OF KANSAS
STATE CORPORATION COMMISSION

Form CP-4

Give All Information Completely
Make Required Affidavit
Mail or Deliver Report to:
Conservation Division
State Corporation Commission
212 No. Market
Wichita, Kansas

WELL PLUGGING RECORD

NORTH

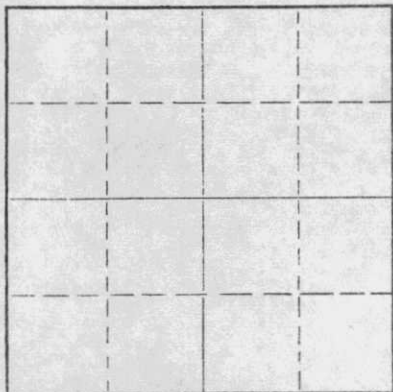Locate well correctly on above
Section Plat

Barber

County. Sec. 6 Twp. 31S Rge. (E) 15 (W)

Location as "NE/CNW/SW" or footage from lines App SW

Lease Owner T. A. Mace

Lease Name Walker

Well No. 1

Office Address 5101 N. Pennsylvania Oklahoma City, Oklahoma

Character of Well (completed as Oil, Gas or Dry Hole) Dry Hole

Date well completed July 7 1967

Application for plugging filed July 7 1967

Application for plugging approved July 7 1967

Plugging commenced July 7 1967

Plugging completed July 7 1967

Reason for abandonment of well or producing formation No producible shows

If a producing well is abandoned, date of last production 19

Was permission obtained from the Conservation Division or its agents before plugging was commenced? Yes

Name of Conservation Agent who supervised plugging of this well Archie V. Elving

Producing formation Depth to top Bottom Total Depth of Well Feet

Show depth and thickness of all water, oil and gas formations.

OIL, GAS OR WATER RECORDS

CASING RECORD

FORMATION	CONTENT	FROM	TO	SIZE	PUT IN	PULLED OUT
				8 5/8"	938'	

Describe in detail the manner in which the well was plugged, indicating where the mud fluid was placed and the method or methods used in introducing it into the hole. If cement or other plugs were used, state the character of same and depth placed, from feet to feet for each plug set.

Mud to 500', 1 sx dry cement, 1/2 sx hulls, plug, 24 sx cement; mud to 40', 1 sx dry cement, 1/2 sx hulls, plug, 9 sx cement; job complete 5:30 AM, 7-7-67.
2 sx cement in mouse hole and 2 sx cement in rat hole.

RECEIVED
STATE CORPORATION COMMISSION

JUL 17 1967

CONSERVATION DIVISION
Wichita, Kansas

(If additional description is necessary, use BACK of this sheet)

Name of Plugging Contractor Garvey Drilling Company

Address Route 2, Great Bend, Kansas

STATE OF Kansas, COUNTY OF Barton, ss.
A. G. Radke

(employee of owner) or (owner) of the above-described well, being first duly sworn on oath, says: That I have knowledge of the facts, statements, and matters herein contained and the log of the above-described well as filed and that the same are true and correct. So help me God.

(Signature)

A. G. Radke

(Address)

SUBSCRIBED AND SWORN TO before me this 14th day of July, 1967

My commission expires May 28, 1969

Richard H. Dunch

Notary Public.

WELL LOG

COMPANY T. A. Mace

SEC. 6 T. 31S R. 15W

FARM Walker

NO. 1

LOC. App SW

TOTAL DEPTH 4680'


COUNTY Barber

COMM. 6-24-67

COMP. 7-7-67

CONTRACTOR Garvey Drilling Company

CASING 8 5/8" @ 938' w/500 SX

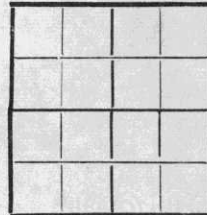

ELEVATION 1911' DF

PRODUCTION D & A

FIGURES INDICATE BOTTOM OF FORMATIONS

15' Clay and Sand
1805' Red Bed and Shale
1880' Shale and Lime
2230' Lime and Shale
2425' Lime
3151' Lime and Shale
3165' Shale and Lime
3935' Lime and Shale
4085' Shale and Lime
4150' Lime and Shale
4535' Lime
4595' Lime and Shale
4680' Lime and Chert
4680' RTD

RECEIVED
STATE CORPORATION COMMISSION

JUL 17 1967

CONSERVATION DIVISION
Wichita, Kansas

State of Kansas

County of Barton

ss

I, Sam N. Stephens of Garvey Drilling Company

upon oath state the above and foregoing is a true and correct copy of the log of the Walker No. 1 well.

Subscribed and sworn to before me this 13th day of July 19 67

My Commission Expires: May 28, 1969

Richard H. Dumbler
NOTARY PUBLIC