


STATE OF KANSAS
STATE CORPORATION COMMISSION

WELL PLUGGING RECORD

Give All Information Completely
Make Required Affidavit
Mail or Deliver Report to:
Conservation Division
State Corporation Commission
800 Bitting Building
Wichita, Kansas

Barber County, Sec 9 Twp. 34S Rge. (E) 13 (W)
Location as "NE/CNWxSWx" or footage from lines NE NE SE
Lease Owner GRAHAM-MESSMAN-RINEHART DRILLING COMPANY
Lease Name Donovan "F" Well No. 1
Office Address 1005 East Second, Wichita, Kansas
Character of Well (completed as Oil, Gas or Dry Hole) Dry Hole
Date well completed September 25, 1955 19
Application for plugging filed September 26, 1955 (verbal) 19
Application for plugging approved September 26, 1955 (verbal) 19
Plugging commenced September 26, 1955 19
Plugging completed September 26, 1955 19
Reason for abandonment of well or producing formation Dry Hole

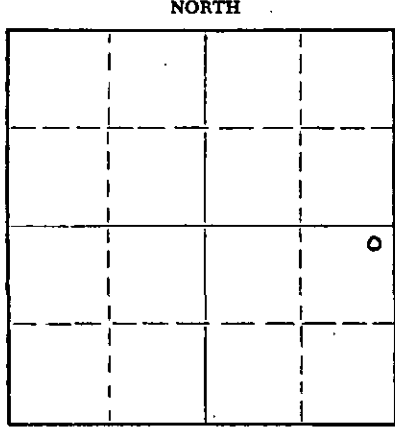

Locate well correctly on above Section Flat

If a producing well is abandoned, date of last production _____ 19
Was permission obtained from the Conservation Division or its agents before plugging was commenced? Yes

Name of Conservation Agent who supervised plugging of this well M. A. Rives, Pratt, Kansas
Producing formation _____ Depth to top _____ Bottom _____ Total Depth of Well 5456 Feet
Show depth and thickness of all water, oil and gas formations.

OIL, GAS OR WATER RECORDS

CASING RECORD

FORMATION	CONTENT	FROM	TO	SIZE	PUT IN	PULLED OUT
				8 5/8"	320'	None

Describe in detail the manner in which the well was plugged, indicating where the mud fluid was placed and the method or methods used in introducing it into the hole. If cement or other plugs were used, state the character of same and depth placed, from _____ feet to _____ feet for each plug set.

Set bottom plug at 300 feet.
Dumped 1/4 sack hulls and 20 sacks cement. Filled hole with heavy drilling mud to 35 feet.
Dumped 1/4 sack hulls and 10 sacks cement.

STATE CORPORATION COMMISSION
SEP 27 1955 9-29-55
CONSERVATION DIVISION
Wichita, Kansas

(If additional description is necessary, use BACK of this sheet)
Name of Plugging Contractor Graham-Messman-Rinehart Drilling Company
Address 1005 East 2nd, Wichita, Kansas

STATE OF Kansas, COUNTY OF Sedgwick, ss.
J. A. Gilliland (employee of owner) or (~~SWORN TO~~) of the above-described well, being first duly sworn on oath, says: That I have knowledge of the facts, statements, and matters herein contained and the log of the above-described well as filed and that the same are true and correct. So help me God.

(Signature) J. A. Gilliland
1005 East Second, Wichita, Kansas
(Address)

SUBSCRIBED AND SWORN TO before me this 28th day of September, 19 55
Juanita L. Lewis
Notary Public.

My commission expires November 5, 1958

PLUGGING
FILE SEC 9 T 34 R 13 W
BOOK PAGE 4 LINE 15

NO. 1 DONOVAN "P"

WELL RECORD

Location: NE 1/4 SE, 9-34S-13W
 Barber County, Kansas
 Operator: Graham-Hessman-Rinehart Drilling Co.
 1005 East Second, Wichita, Kansas
 Contractor: Graham-Hessman-Rinehart Drilling Co.
 1005 East Second, Wichita, Kansas
 Casing Record: 8 5/8" x 320' w/225 sacks cement

Commenced: September 7, 1955
 Completed: September 26, 1955
 Elevation: 1729 KB
 Production: OGA

.....L () O.....

Clay	40
Red Red-Sand	950
Shale-Shells	1595
Shale-Lime	2010
Lime-Shale	2645
Shale-Lime	3050
Lime-Shale	3395
Shale-Lime	3810
Lime-Shale	3935
Shale-Lime-Sand	4055
Lime	4058
Lime-Shale	4119
Shale-Lime	4225
Lime	4395
Lime-Shale	4440
Lime	4647
Lime-Shale	4710
Lime	4775
Shale	4825
Lime-Chert	4886
Chert-Lime	4919
Lime-Chert	5007
Lime-Shale	5028
Shale	5155
Viola	5196
Lime-Chert	5253
Dolomite	5284
Lime	5307
Shale	5360
Shale-Sand	5401
Sand-Artuckle	5446
Artuckle	5456 N.T.D.

Sample Tests

Douglas Sand 4028 (-2299)
 Brown Lime 4193 (-2464)
 Lansing 4198 (-2469)
 Hamaton 4710 (-3011)
 Miss. (Cowley) 4781 (-3352)
 Viola 5116 (-3417)
 Simpson 5260 (-3531)
 Artuckle 5405 (-3676)

The undersigned, GRAHAM-HESSEMAN-RINEHART DRILLING COMPANY, hereby certifies that the above log is a true and correct log of the formation encountered in drilling the above well as reflected by the Daily Drilling Report.

GRAHAM-HESSEMAN-RINEHART DRILLING COMPANY

By: J. K. Gilliland
 J. K. Gilliland

Subscribed and sworn to before me this 26th day of September, 1955.

Juanita L. Fovis
 Notary Public

My Commission Expires: November 5, 1958

PLUGGING
 FILE REC-9 T 34 R 134
 BOOK PAGE 4 LINE 15