


STATE OF KANSAS
STATE CORPORATION COMMISSION

WELL PLUGGING RECORD

Give All Information Completely
Make Required Affidavit
Mail or Deliver Report to:
Conservation Division
State Corporation Commission
800 Bitting Building
Wichita, Kansas

Barber County, Sec. 7 Twp. 30S Rge. 13W (E) W (W)
Location as "NE/CNW/SE" or footage from lines NE NE SE
Lease Owner Fred B. Anschutz
Lease Name Kanckstedt Well No. 1
Office Address 709 Union National Bank Building
Character of Well (completed as Oil, Gas or Dry Hole) Dry Hole
Date well completed 11-23-54 19 54
Application for plugging filed October 30, 19 54
Application for plugging approved October 30, 19 54
Plugging commenced October 30, 19 54
Plugging completed October 30, 19 54
Reason for abandonment of well or producing formation Dry Hole

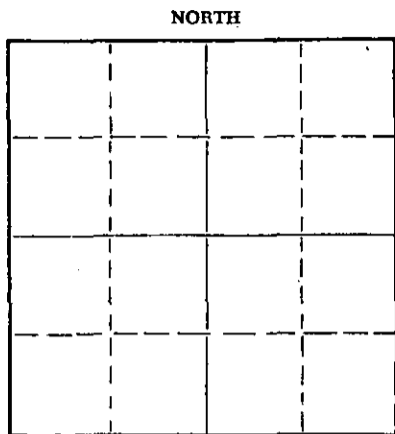

Locate well correctly on above
Section Plat

If a producing well is abandoned, date of last production 19
Was permission obtained from the Conservation Division or its agents before plugging was commenced? Yes

Name of Conservation Agent who supervised plugging of this well M. A. Rives - Pratt, Kansas
Producing formation Depth to top Bottom Total Depth of Well 759' Feet
Show depth and thickness of all water, oil and gas formations.

OIL, GAS OR WATER RECORDS

CASING RECORD

| FORMATION | CONTENT | FROM | TO | SIZE | PUT IN | PULLED OUT |
|-----------|---------|------|----|--------|--------|------------|
| | | | | 8 5/8" | 355' | None |
| | | | | | | |
| | | | | | | |
Describe in detail the manner in which the well was plugged, indicating where the mud fluid was placed and the method or methods used in introducing it into the hole. If cement or other plugs were used, state the character of same and depth placed, from feet to feet for each plug set.

Bottom plug set at 300' w/ 20 sacks cement.
Top plug set at 40' w/ 10 sacks cement.

11-27-1954

(If additional description is necessary, use BACK of this sheet)
Name of Plugging Contractor Anschutz Drilling Co., Inc.
Address 709 Union National Bank Building

STATE OF Kansas, COUNTY OF Sedgwick, ss.
E. G. Koelling (employee of owner) or (owner or operator) of the above-described well, being first duly sworn on oath, says: That I have knowledge of the facts, statements, and matters herein contained and the log of the above-described well as filed and that the same are true and correct. So help me God.

(Signature) E. G. Koelling
709 Union National Bank Building (Address)

SUBSCRIBED AND SWORN TO before me this 26th day of November, 19 54

Charlenne Barlowe
Notary Public.

My commission expires July 28, 1958

PLUGGING
FILE SEC 7 T 30 R 13W
BOOK PAGE 24 LINE 39