


WELL PLUGGING RECORD

Give All Information Completely  
Make Required Affidavit  
Mail or Deliver Report to:  
Conservation Division  
State Corporation Commission  
800 Biting Building  
Wichita, Kansas

NORTH

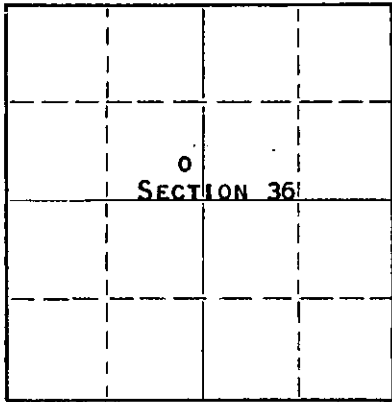

Locate well correctly on above Section Plat

BARBER County, Sec. 36 Twp. 31 Rge. 10 (X) W (W)  
Location as "NE/CNWxSWx" or footage from lines SE SE NW  
Lease Owner PETROLEUM, INC.  
Lease Name BEST "B" Well No. 1  
Office Address ROUTE 2, GREAT BEND, KANSAS  
Character of Well (completed as Oil, Gas or Dry Hole) DRY HOLE  
Date well completed OCTOBER 20 19 56  
Application for plugging filed OCTOBER 22 19 56  
Application for plugging approved OCTOBER 20 19 56  
Plugging commenced OCTOBER 20 19 56  
Plugging completed OCTOBER 20 19 56  
Reason for abandonment of well or producing formation NO PRODUCIBLE ZONES

If a producing well is abandoned, date of last production NONE 19  
Was permission obtained from the Conservation Division or its agents before plugging was commenced? YES

Name of Conservation Agent who supervised plugging of this well M. A. RIVES, PRATT, KANSAS  
Producing formation ----- Depth to top ----- Bottom ----- Total Depth of Well 4,580 Feet  
Show depth and thickness of all water, oil and gas formations.

OIL, GAS OR WATER RECORDS

CASING RECORD

FORMATION	CONTENT	FROM	TO	SIZE	PUT IN	PULLED OUT
				8-5/8"	229'	NONE

Describe in detail the manner in which the well was plugged, indicating where the mud fluid was placed and the method or methods used in introducing it into the hole. If cement or other plugs were used, state the character of same and depth placed, from \_\_\_\_\_ feet to \_\_\_\_\_ feet for each plug set.

MUD UP WITH HEAVY MUD TO 225' PUSHED DOWN 1/4 SACK HULLS TO 225' FOLLOWED BY WOODEN PLUG. PLACED 20 SACKS CEMENT THROUGH DRILL PIPE ONTO PLUG. MUD UP TO 35' AND PLACED 1/4 SACK HULLS TO 35' FOLLOWED BY WOODEN PLUG AND 10 SACKS CEMENT TO BASE OF WELL CELLAR.

RECEIVED  
STATE CORPORATION COMMISSION  
OCT 25 1956  
CONSERVATION DIVISION  
Wichita, Kansas  
10-26-56

(If additional description is necessary, use BACK of this sheet)

Name of Plugging Contractor GARVEY DRILLING COMPANY  
Address ROUTE 2 GREAT BEND, KANSAS

STATE OF KANSAS, COUNTY OF BARTON, ss.  
DON SEARIE (employee of owner) or (conservation agent) of the above-described well, being first duly sworn on oath, says: That I have knowledge of the facts, statements, and matters herein contained and the log of the above-described well as filed and that the same are true and correct. So help me God.

(Signature) Don Searie  
ROUTE 2 GREAT BEND, KANSAS  
(Address)

SUBSCRIBED AND SWORN TO before me this 24TH day of OCTOBER 19 56

My commission expires JULY 11, 1960 Notary Public.

PLUGGING  
FILE SEC. 36 T. 31 R. 10 W.  
BOOK PAGE 109 LINE 39

# WELL LOG

COMPANY PETROLEUM, INCORPORATED

SEC. 36 T. 31S R. 10W

FARM BEST 'B' NO. 1


LOC. SE,SE,NW

TOTAL DEPTH 4580'

COUNTY Barber Co., Kansas

COMM. October 7, 1956 COMP. October 20, 1956

CONTRACTOR GARVEY DRILLING COMPANY

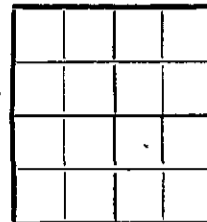

CASING 8 5/8" @ 229' W/150 sax.

ELEVATION 1641' DF

PRODUCTION D & A

FIGURES INDICATE BOTTOM OF FORMATIONS

50	Surface sand	Heebner	3609'
230	Sand & red bed	Toronto	3648'
488	Red bed	Douglas	3683'
1100	Red bed & shale	Lansing	3769'
1600	Shale & shells	Kansas City	4046'
1630	Shale & shells W/lime		
1935	Lime & shale		
2200	Lime		
2365	Shale & lime		
2560	Shale		
2760	Shale & shells		
3738	Lime & shale		
3805	Douglas sand		
4372	Lime		
4425	Lime & shale		
4452	Lime		
4560	Lime & shale		
4580	Mississippi lime		
4580	T. D.		

RECEIVED  
STATE COMMISSION  
OCT 18 1956  
CORRECTION DIVISION  
WELL REGISTRY

State of KANSAS }  
County of BARTON } ss:

PLUGGING  
FILE SEC. 36 T. 31 R. 10W  
BOOK PAGE 109 LINE 39

I, Verne A. Morris of Garvey Drilling Co.

upon oath state that the above and foregoing is a true and correct copy of the log of the #1 Best 'B' well

Verne A. Morris

Subscribed and sworn to before me this 23rd day of October 19 56

My Commission Expires: July 11, 1960

Zed J. Brown  
NOTARY PUBLIC